
N

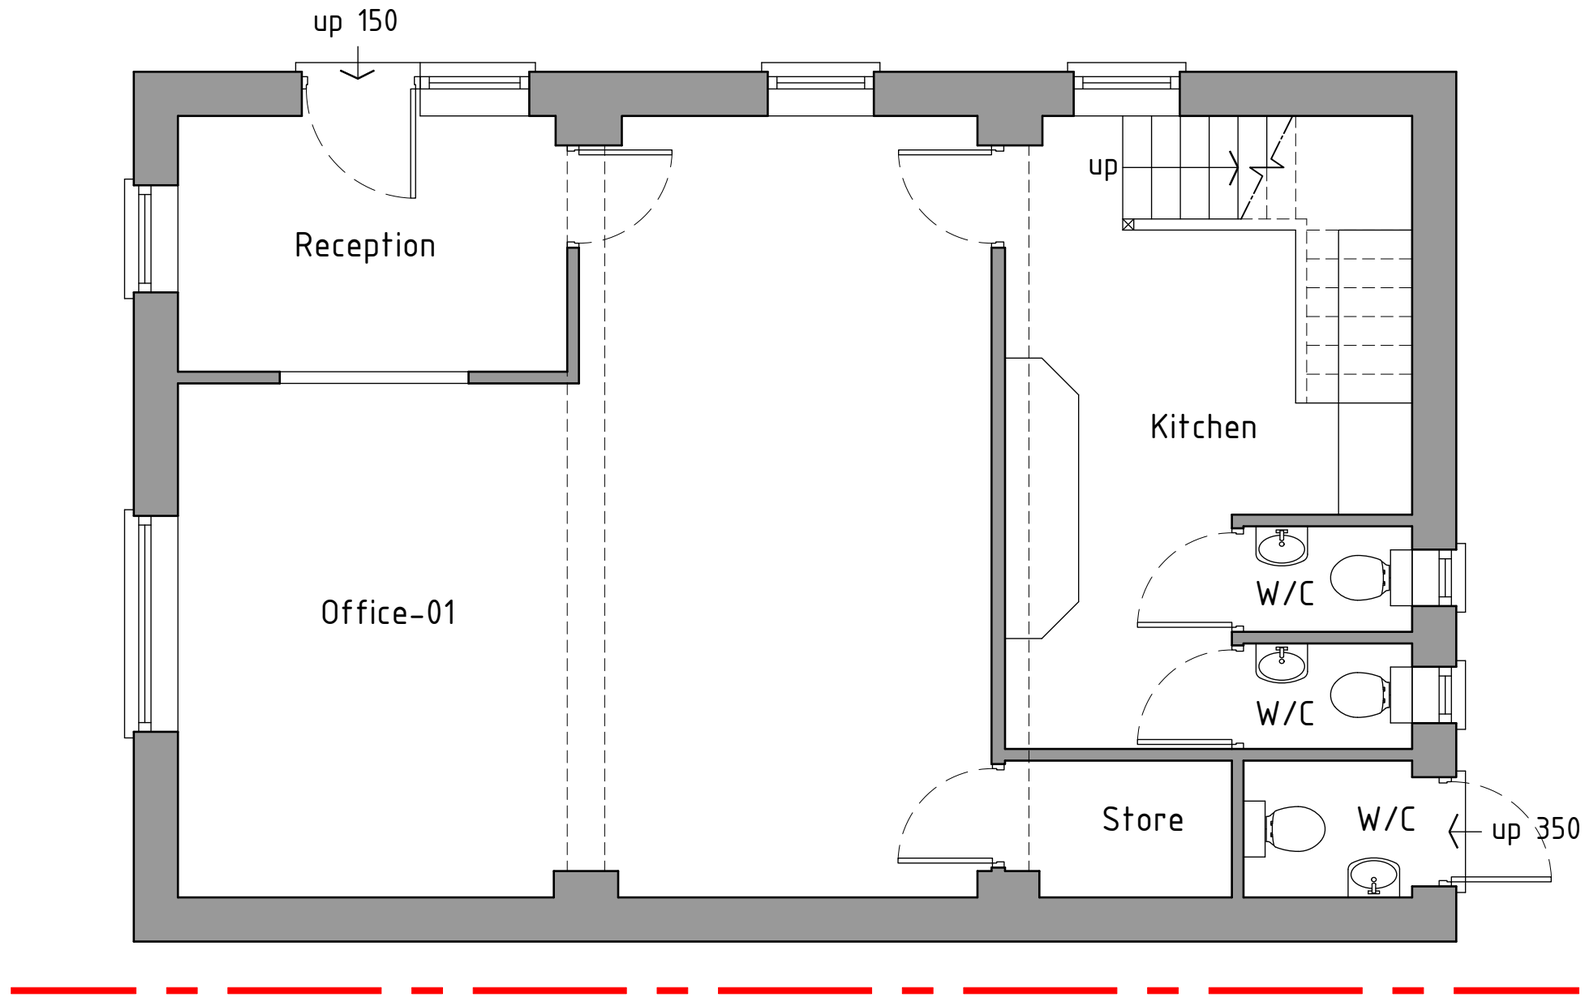


Ground floor plan 1:50

As Built

HDS ARCHITECTURAL SERVICES
HDS Architectural Services, The Foundry,
15 Yorke Street, Wrexham
LL13 8LW
Tel (01978) 345250
www.hdsarchitectural.co.uk

**Project;**
Office unit, S&L Areospace Engineering LTD, The Old Coal Yard, Park Road, Wrexham, LL143YP

| **Title;** | **Scale (A3);** |
|---|---|
| 01-As Built Ground Floor Plan | 1:50 |
| **Dwg No;** | **Date;** |
| SOS/PD/01 | 13.01.25 |

**Revision;**