
Notes

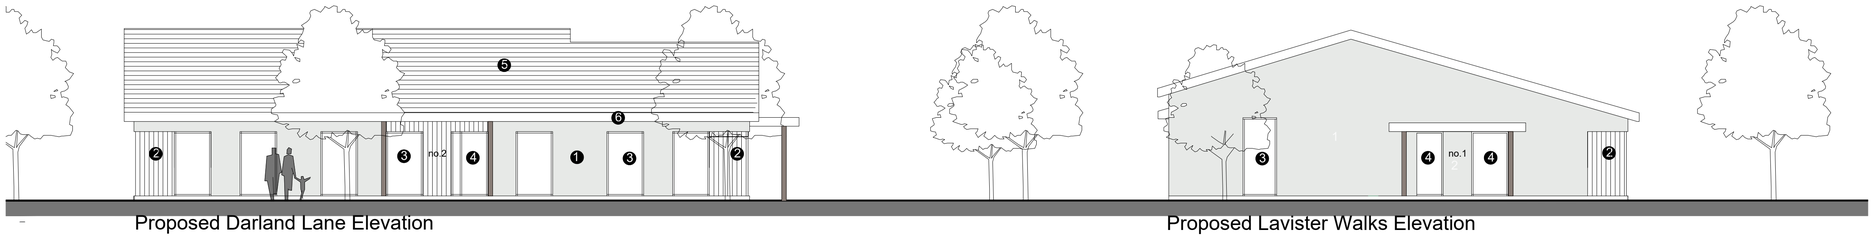


Proposed Darland Lane Elevation


Proposed Lavister Walks Elevation



Proposed Rear Elevation

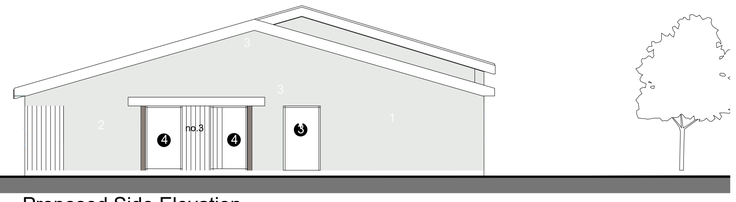

Proposed Side Elevation

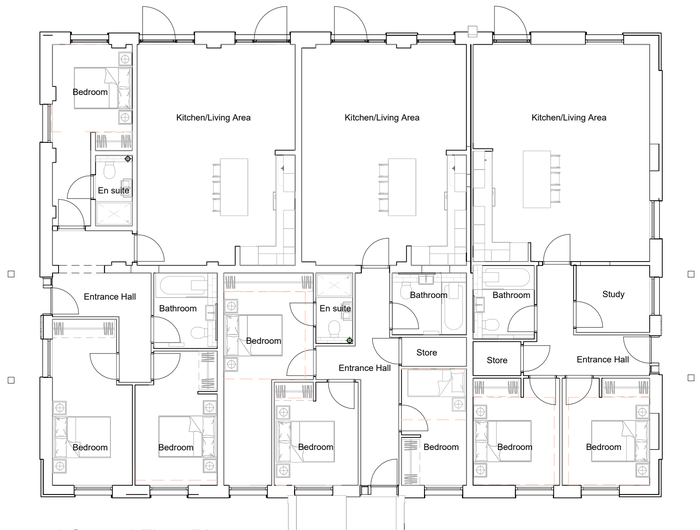

Proposed Ground Floor Plan

Key to materials

subject to approval

1. Render Sample Colour to be approved.
2. Vertical timber cladding
3. Aluminium windows in dark grey
4. Aluminum Doors finished in Dark Grey
5. Roof Tiles
6. Aluminium soffits and fascias

As Existing Ground Floor

As Existing

HDS Architectural Services, The Foundry,
15 Yorke Street, Wrexham
LL13 8LW
Tel (01978) 345250
www.hdsarchitectural.co.uk

Project; Barton House, Darland Lane, Rossett, Wrexham, LL12 0EL

Dwg No; DL/PD/01

Date; 20.01.25

Revision; ...

Title; 01-As Built Floor Plan and Elevations

Scale (A1); 1:100