In line with current company policy, DAY Architectural's starting position for selection of all external wall materials and attachments on all buildings shall carry a 'reaction to fire' (RtF) classification of either A1 or A2-s1, d0 (A1fl or A2fl-s1, d0 in the case of balcony floors) with exception of the exemptions listed in Regulation 7(3).
Our position, as outlined above, is supported by guidance observed in ADB vol. 1 & 2 which states;


"In relation to buildings of any height or use, consideration should be given to the choice of materials (including their extent and arrangement) used for the external wall, or attachments to the wall (e.g. balconies, etc.), to reduce the risk of fire spread over the wall."

This guidance is supplementary to the classifications given in Table 10.1 in ADB vol. 1 (and Table 12.1 in ADB vol. 2). Therefore, irrespective of building height and use, the risk of external fire spread, followed by the potential breach of compartmentation remains a significant risk to life, particularly where external wall materials with an RtF classification of less than A2-s1,d0 are used.

In light of the above, DAY Architectural Ltd accept no liability for the installation of external wall materials including attachments other than those carrying an RtF classification of A1 or A2-s1,d0, unless listed as an exemption under Regulation 7(3).

All products to be equal and approved


Strucural & Mechanical model to be revised to suit

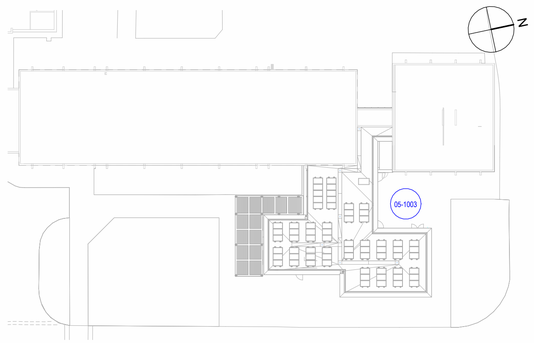


External Finishes Key

1. Blue/Grey Engineering Brick F10/110
2. Fibre Cement Cladding - Equitone Graphite with projecting gold metal fin between vertical sheets.
3. Metal Diamond Cladding - Gold
4. P.P.C Profiled Fascia / Structural Canopy Support - RAL7012
5. P.P.C Thermally broken aluminium glazing - RAL7012
6. P.P.C Louvre Panel - RAL 7012
7. Anodised thermally broken aluminium glazing - Gold
8. Anodised louvre panel - Gold
9. Clear Glazing
10. Spandrel Glass - Enamel Back RAL 7012
11. P.P.C Aluminium Flashing - RAL 7012
12. Roof Edge Protection - Metal Railing

Elevation Key Plan - Sheet 2

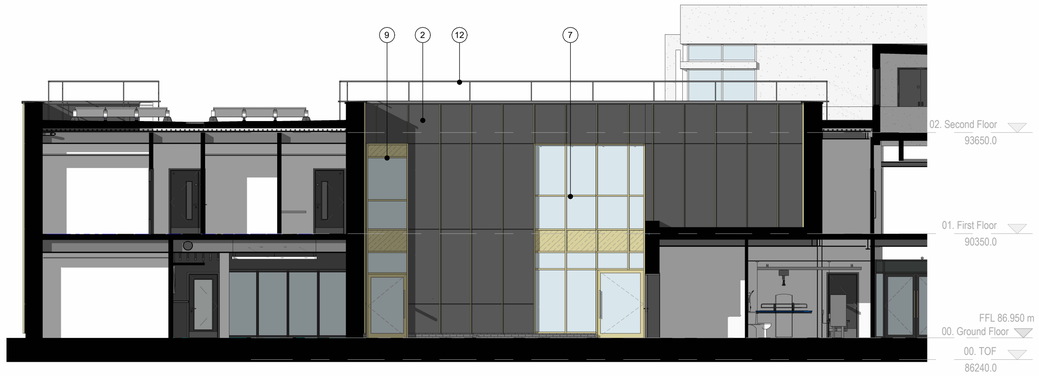


5 Proposed North Elevation/Section Phase 2B_SS
1 : 100

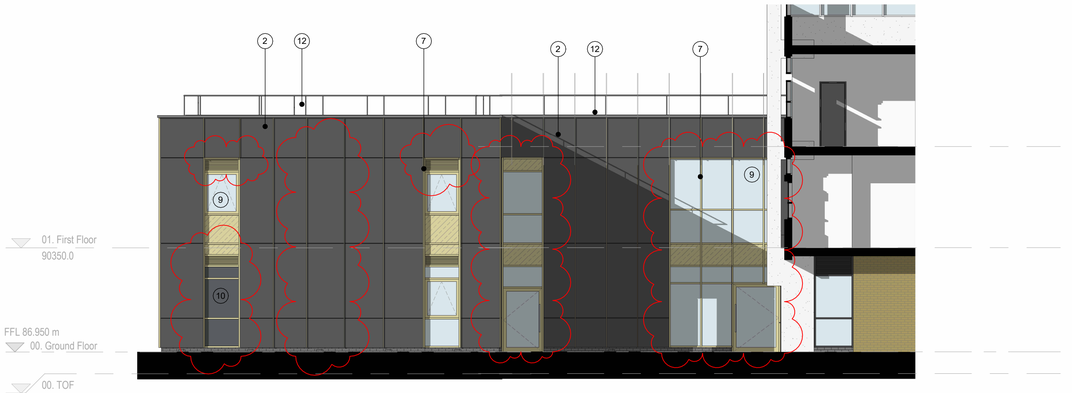

2 Proposed GA North Elevation Phase 2B_P
1 : 100



1 Proposed GA West Elevation/Section_P
1 : 100

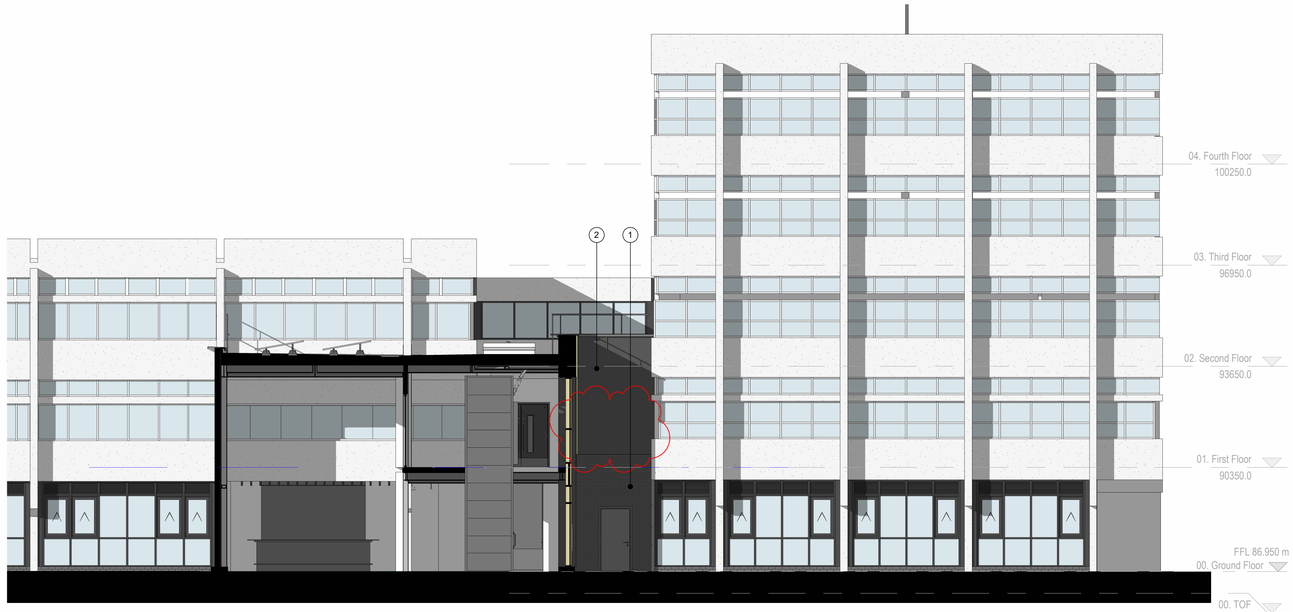

4 Proposed M Block GA Elevation/Section_P
1 : 100

GENERAL NOTES:

DAY Architectural Ltd does not warrant or take responsibility for any costs, losses or claims whatsoever arising from these drawings, specifications and related documents unless there is full compliance by the intended recipient or user with the following:

1. All boundaries, dimensions and levels are to be checked on site before construction and any discrepancies reported to the Architect / Designer prior to commencement of any works.
2. Planning Service: Any discrepancies with site or other information is to be advised to the Architect / Designer and direction and / or approval is to be sought before the implementation of the detail.
3. Block and site plans are reproduced under license from the Ordnance Survey.
4. Do not scale off drawings. Any measurements taken from information which is not dimensioned on the electronic copy are at the risk of the recipient.
5. For the purpose of coordination, all relevant parties must check this information prior to implementation and report any discrepancies to the Architect / Designer. The information must solely and only be used for the coordination and/or construction of the current project.
6. The copyright of the original documents belongs to DAY Architectural Limited. The information is only for use in preparation of documents for this project. The information issued may be confidential and must not be used other than by the intended recipient.
7. The recipient is responsible for verifying the correctness and completeness of the information issued. This should be done by consulting all relevant associated documents including but not limited to information provided by the Civil / Structural Engineer, M&P Engineer(s), Fire Engineer, Acoustician, Highways Consultant, Flood Risk Assessor, Party Wall Assessor and any other project designers / consultants supplied during the course of the project and by confirming dimensions on site.
8. It is the responsibility of the recipient to ensure they have the most up to date information.
9. If altered or added to in any way, all references to DAY Architectural Limited must be removed and those making the changes assume total responsibility for the information thereon.
10. The Architect does not warrant that planning permission, Building Control/Building Safety Regulator Approval and other approvals from third parties shall be granted at all or, if granted, will be granted in accordance with any anticipated timescale. All designs provided are subject to such approval.
11. Any façade/cladding design provided by DAY Architectural Limited is in relation to indicative design intent only and DAY Architectural Limited shall have no contractual or insurance liability for such design howsoever provided.
12. Do not scale off drawings. Any measurements taken from information which is not dimensioned on the electronic copy are at the risk of the recipient.
13. Record issue *represents the final revision of the construction issue prepared by the Architect. Information issued as 'Record' is not intended to show the works as constructed. The Architect is under no obligation to certify or confirm that the works have been carried out by the contractor in accordance with the Record issue. Any work undertaken based on the information contained in this drawing/document must be verified through site investigation and/or survey to ensure it can proceed safely and in compliance with all necessary requirements. DAY Architectural Ltd accepts no liability for any changes made on-site without the prior knowledge of the Architect.*

0 1 2 3 4 5 10m
GRAPHIC SCALE: 1:100

REV	DESCRIPTION	DATE	REV BY	CHKD BY
P4	Plant room door moved back to original location	24.01.25	OV	
P3	Issued for NMA - as per revision clouds: WEST: louvers added. NORTH: GF window removed and made spandrel panel; middle panels windows removed. NORTH: left hand side panels width amended; curtain walling layout revised following proposed lift; plant room door added. M BLOCK: plant room door removed	09.01.25	GZ	OV
P2	Phase 2B - Revised Planning Issue	04.09.23	RPB	CB
P1	Phase 2B - Planning Issue	10.08.23	RPB	CB

CLIENT
Wrexham University

PROJECT
HEIQ Phase 2B

DRAWING
Proposed Elevations Phase 2B Sheet 2

SCALE
As indicated @ A1

FIRST ISSUED
10.08.23

PROJECT	DRAWN BY	CHECKED BY
HEIQ	RPB	DO

ORIGIN	VOLUME	LEVEL	TYPE	ROLE	NUMBER	REVISION
DAY	XX	XX	DR	A	05-1003	P4

DRAWING STATUS
PLANNING

Information contained on this drawing is the sole copyright of DAY Architectural Ltd. and is not to be reproduced without their permission.

DAY Architectural Ltd.
Studio 1, Lancaster Buildings
77 Deansgate, Manchester, M3 2BW

T: 0161 834 9703
W: www.day-architectural.com