

Notes

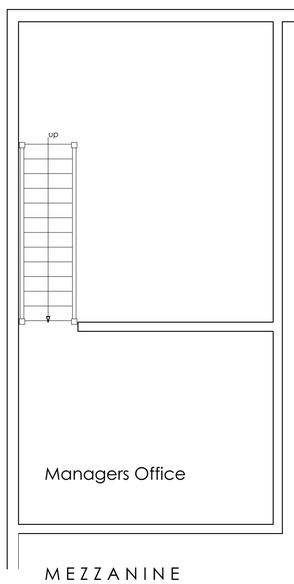

MEZZANINE

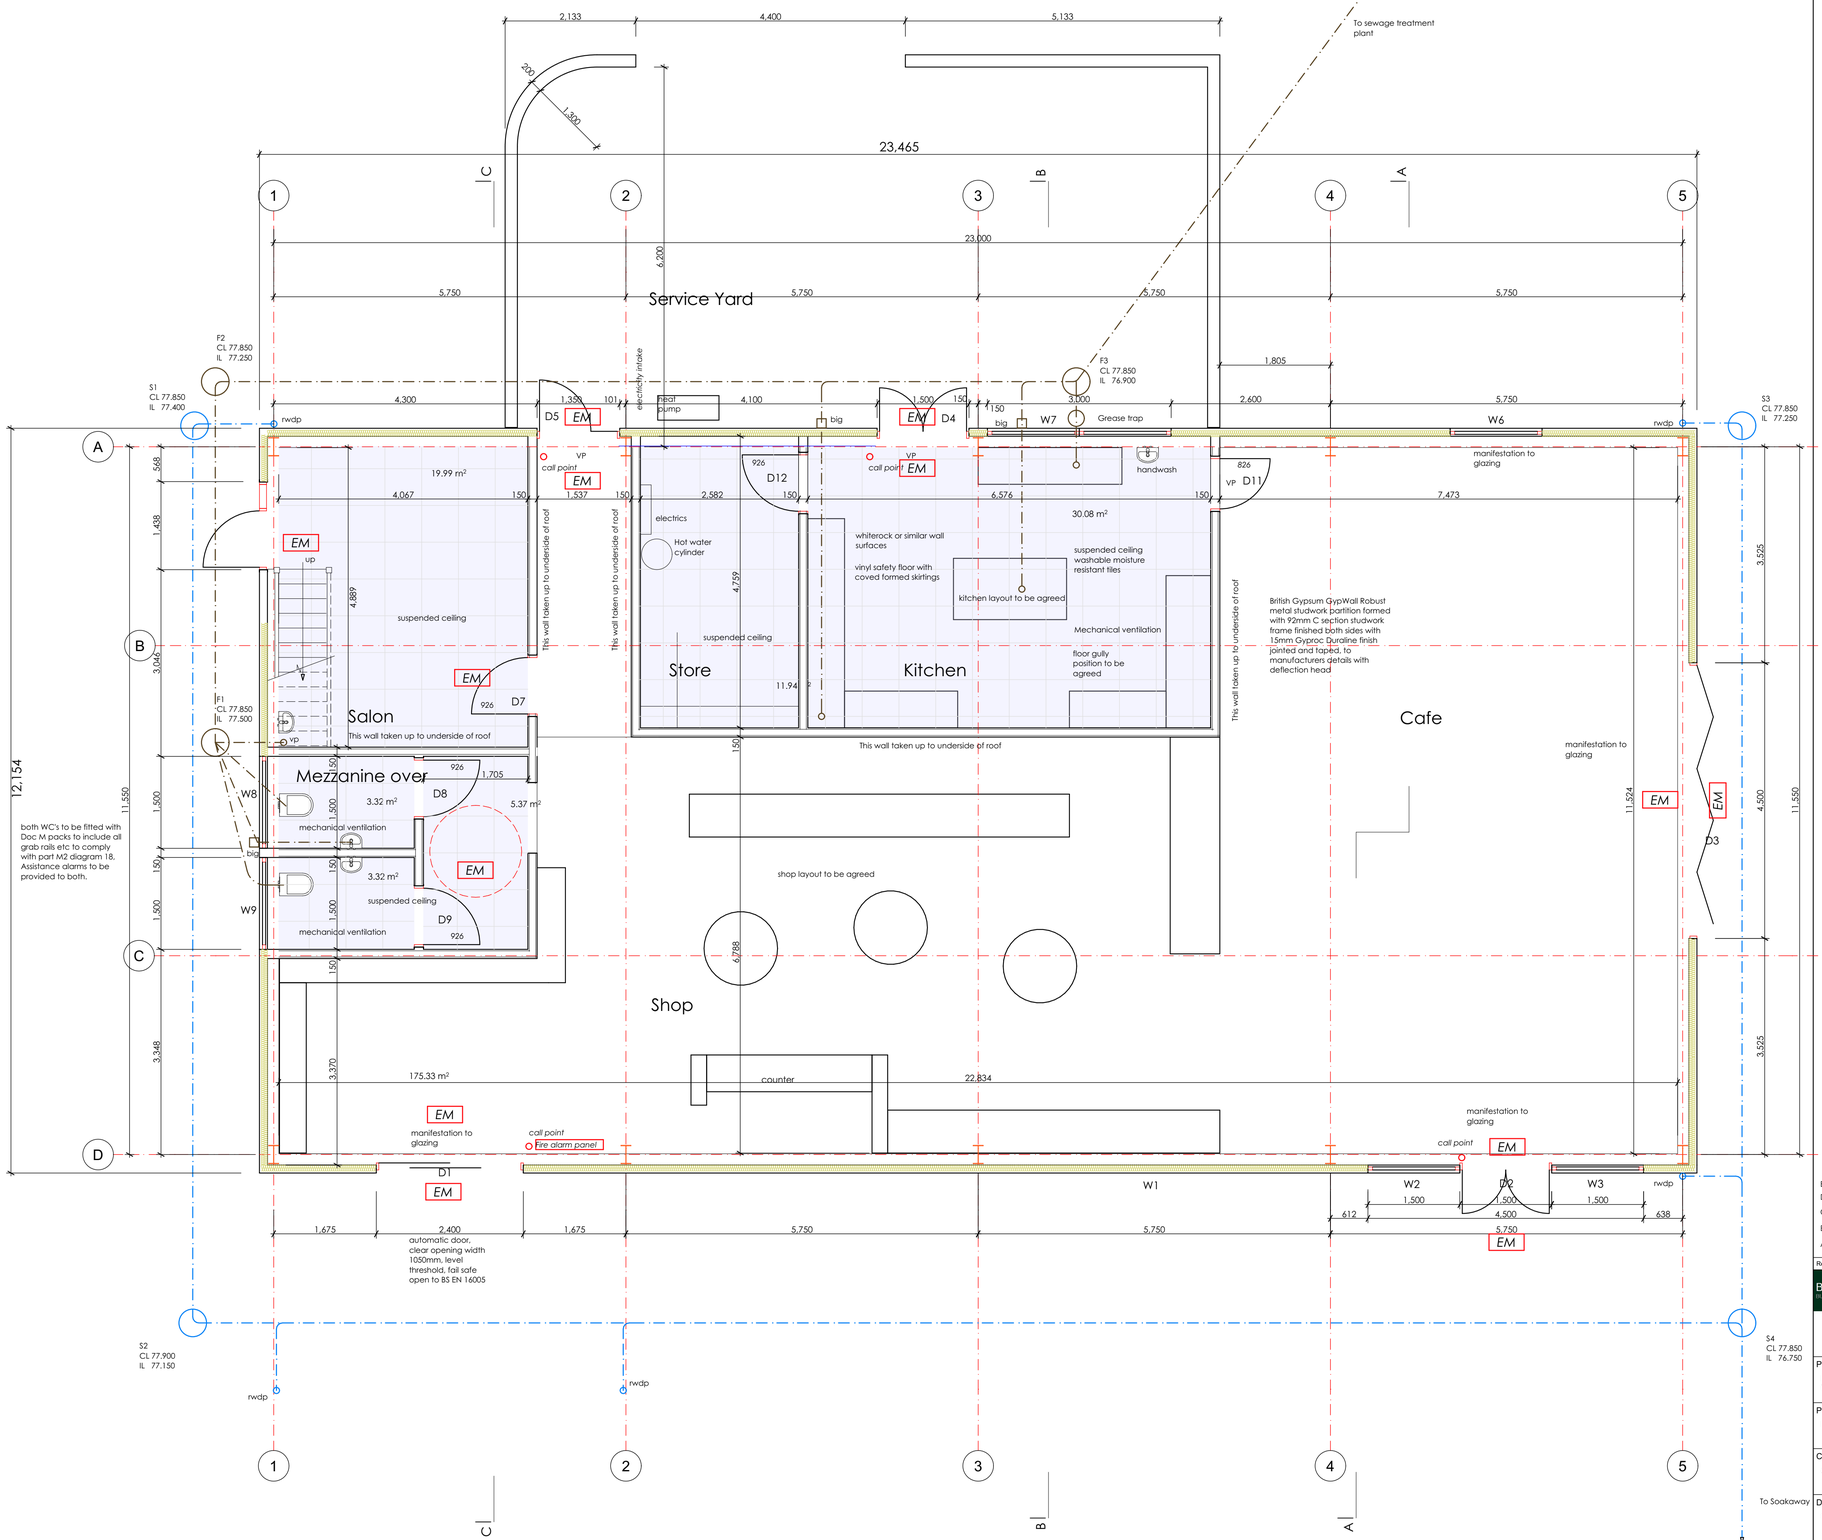

Revision	Description	Date
E	As Built	Jan 2025
D	Minor alterations	May 2024
C	Minor alterations	May 2024
B	Specification revised	March 2022
A	Building Regulations	October 2021

BLEAZARD & GALLETTA LLP
BUILDING DESIGN AND CONSTRUCTION CONSULTANTS
Maypole Court, 2 High Street, Wem, Shropshire, SY4 5AA
Telephone: 01939 235 303 Fax: 01939 235 344
E-mail: info@bgbuildingconsultants.co.uk
Web: www.bgbuildingconsultants.co.uk

Project Location
Rackery Farm, Higher Lane, Burton,Rossett, Wrexham, LL120AD

Project Description
Proposed Farm Shop

Client
A & J Jones

Drawing
Ground Floor Plan

Scale 1:50 @ A1

September 2021

Drawing Number
2026 D 10 Rev E

THE COPYRIGHT OF THIS DRAWING IS VESTED IN BLEAZARD AND GALLETTA LLP AND CANNOT BE COPIED OR REPRODUCED IN WHOLE OR IN PART WITHOUT THEIR WRITTEN CONSENT. DO NOT SCALE FROM THIS DRAWING. REPORT ANY ERRORS IMMEDIATELY.