
The content of this drawing is subject to the provision of the Copyright Act 1956.


Work to figured dimensions only. Site dimensions are to be checked before work is started. Any discrepancy whatsoever between any information contained on this drawing and any other document or drawing must be drawn to the attention of the Architect by the contractor before the work is executed.

IF IN DOUBT ASK IMMEDIATELY.

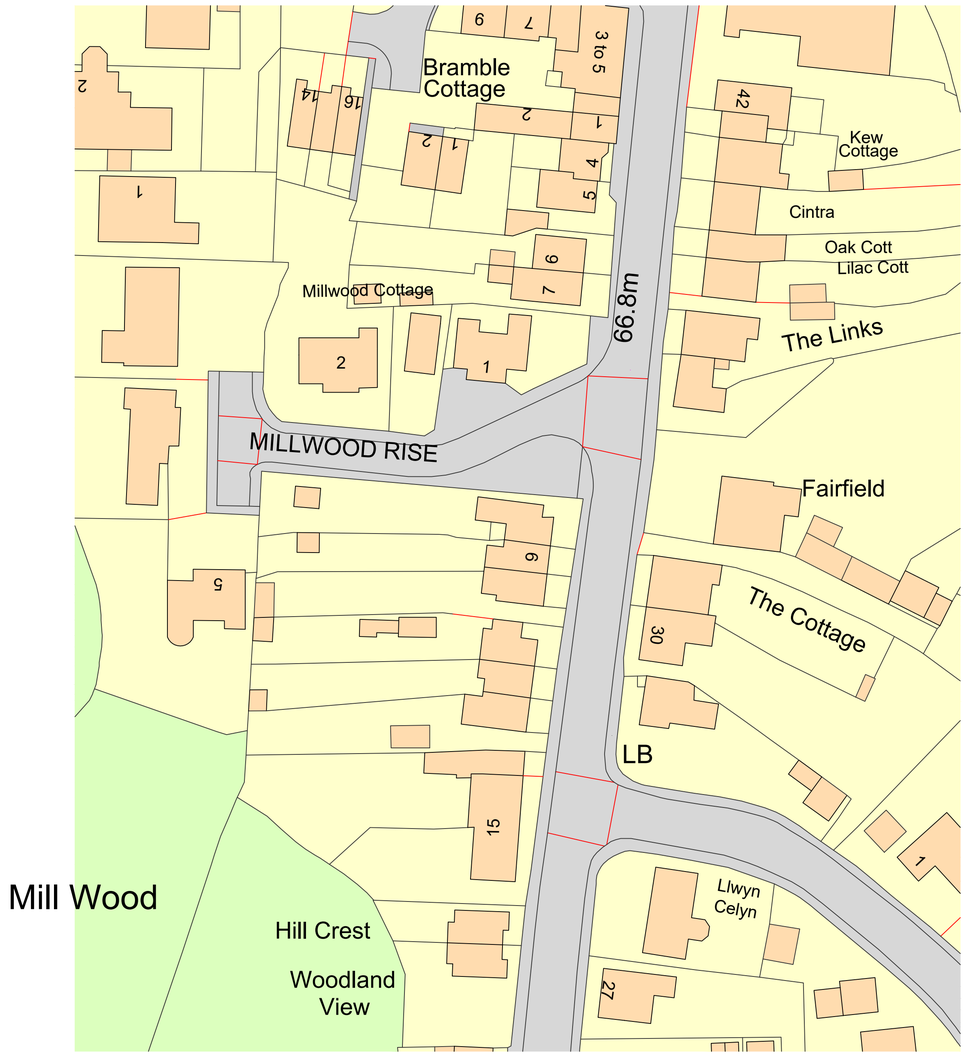

BLOCK PLAN 1 : 500

NORTH

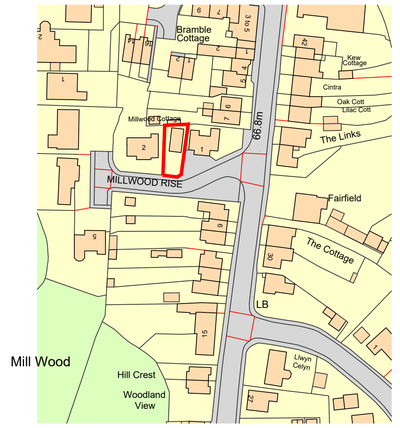

Ordnance Survey, (c) Crown Copyright 2025. All rights reserved. Licence number 100022432

LOCATION PLAN 1 : 1250

RIBA Chartered Practice

MARK WILLACY ARCHITECTS

client
MRS RACHEL CLACHER

job
REAR EXTENSION MILLWOOD COTTAGE, MILLWOOD RISE,
OVERTON, WREXHAM, LL13 0EL

title
GENERAL ARRANGEMENT AS BUILT

scale	date	job no.	drawing no.	rev
1:500/1250@A1	22 MAY'25	MSW208	GA01	

A :- Penmon House, 76 Hoole Road, Chester CH2 3NL
T :- +44 (0)1244 853891 / +44 (0)7973 322953
E :- mark@markwillacyarchitects.co.uk
www :- markwillacyarchitects.co.uk