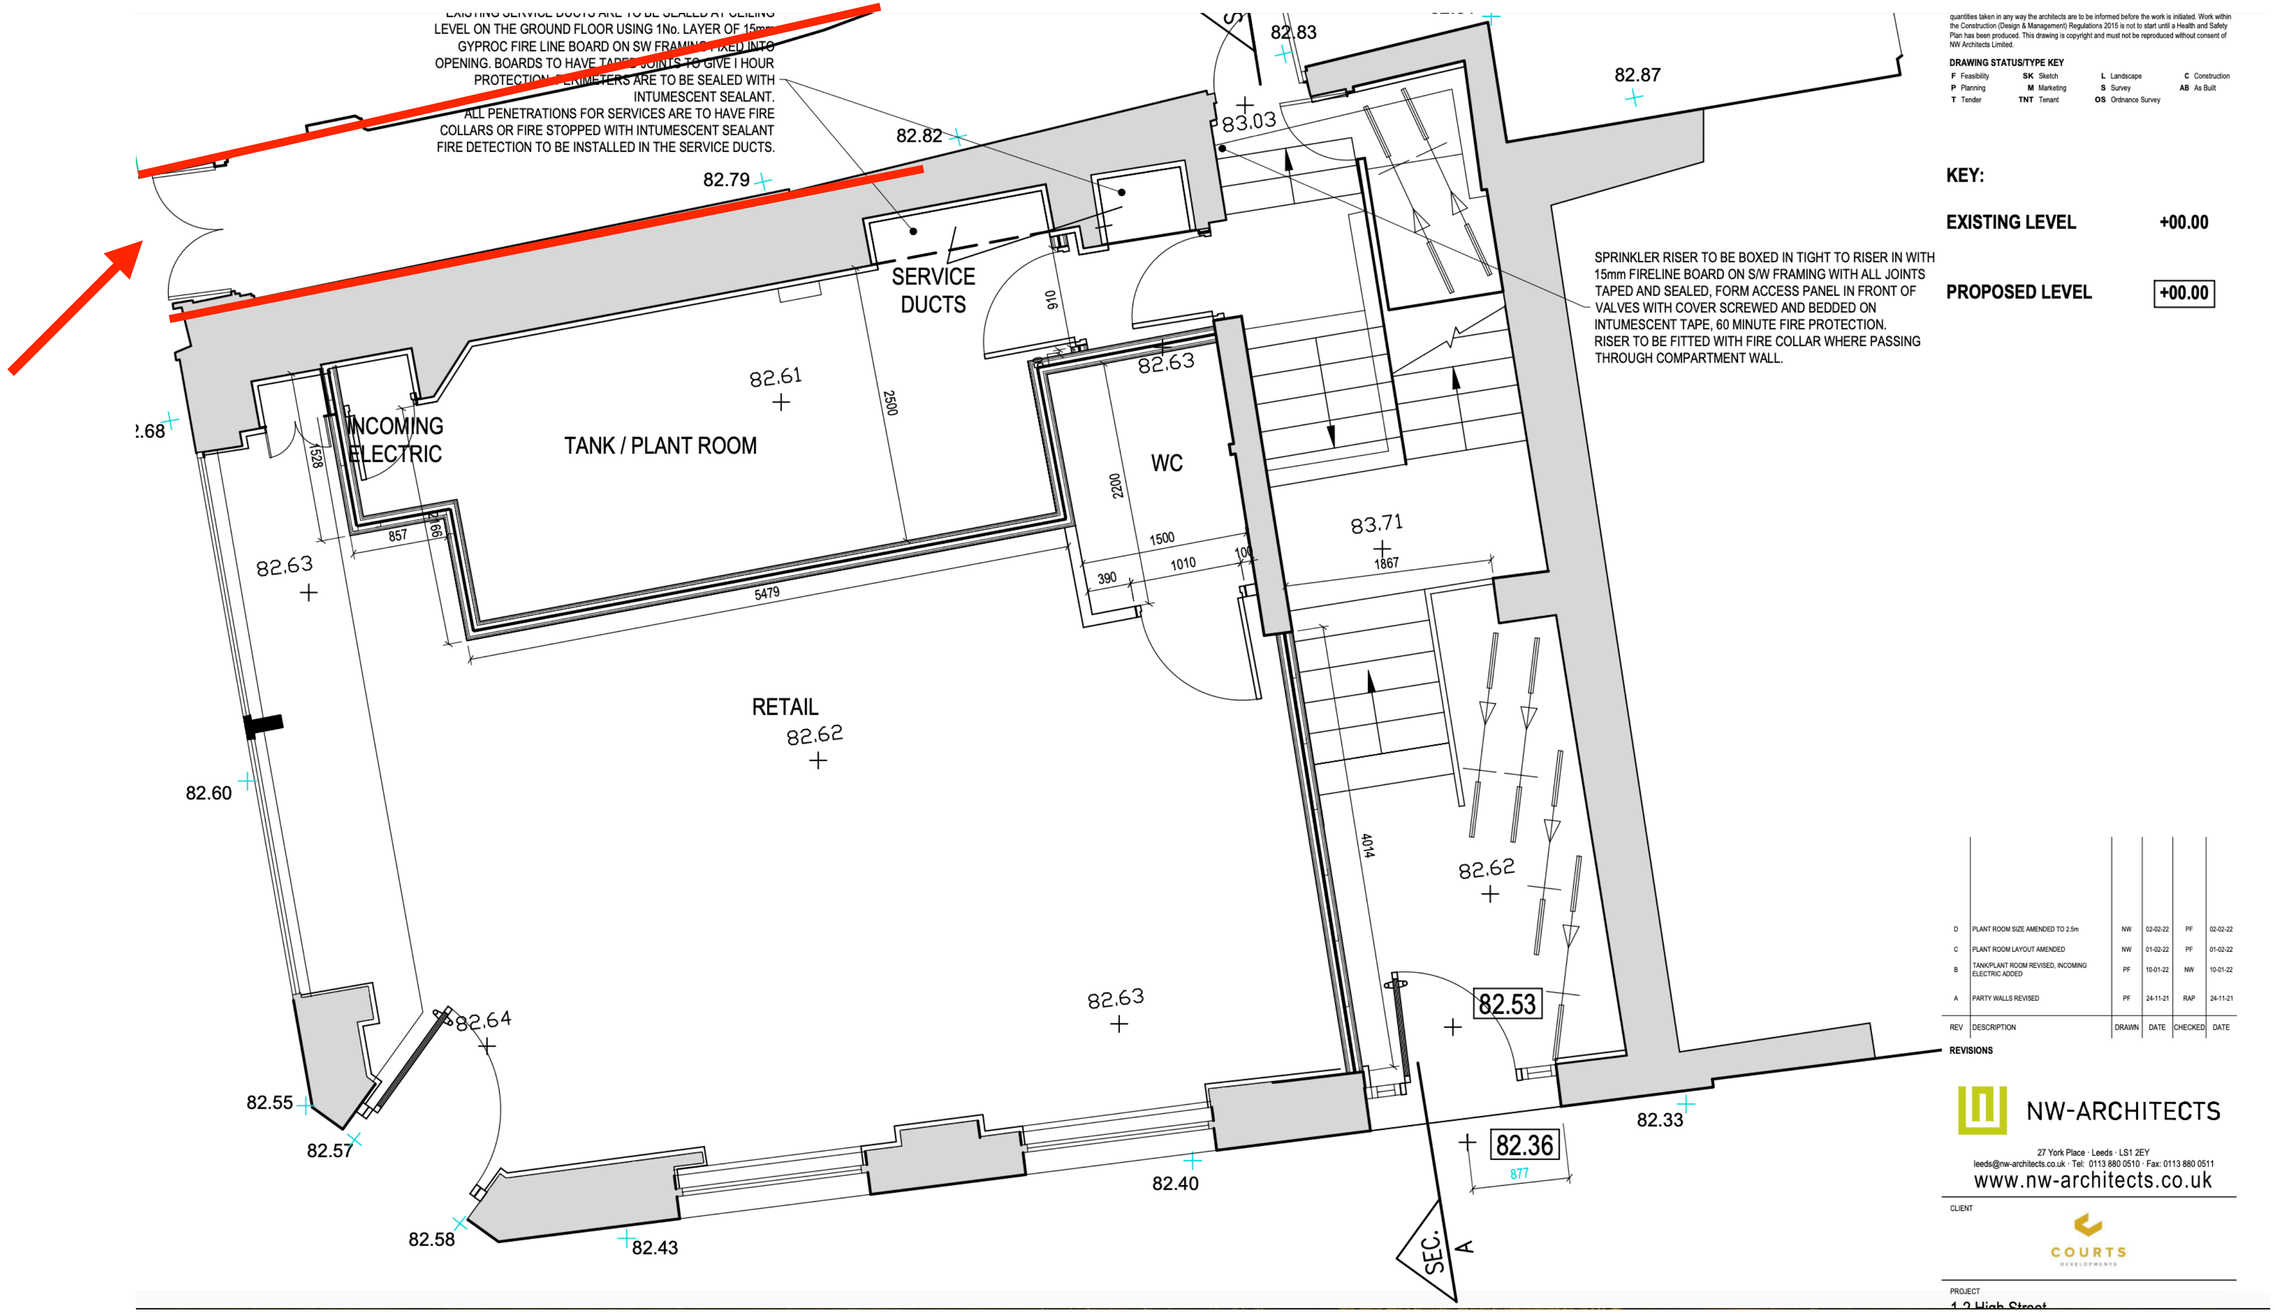


quantities taken in any way the architects are to be informed before the work is initiated. Work within the Construction (Design & Management) Regulations 2015 is not to start until a Health and Safety Plan has been produced. This drawing is copyright and must not be reproduced without consent of NW Architects Limited.

DRAWING STATUS/TYPE KEY

F	Feasibility	**SK**	Sketch	**L**	Landscape	**C**	Construction
P	Planning	**M**	Marketing	**S**	Survey	**AB**	As Built
T	Tender	**TNT**	Tenant	**OS**	Ordnance Survey		

KEY:

EXISTING LEVEL +00.00

PROPOSED LEVEL +00.00

REV	DESCRIPTION	DRAWN	DATE	CHECKED	DATE
D	PLANT ROOM SIZE AMENDED TO 2.5m	NW	02-02-22	PF	02-02-22
C	PLANT ROOM LAYOUT AMENDED	NW	01-02-22	PF	01-02-22
B	TANKPLANT ROOM REVISED, INCOMING ELECTRIC ADDED	PF	10-01-22	NW	10-01-22
A	PARTY WALLS REVISED	PF	24-11-21	RAP	24-11-21

REVISIONS

NW-ARCHITECTS
27 York Place · Leeds · LS1 2EY
leeds@nw-architects.co.uk · Tel: 0113 880 0510 · Fax: 0113 880 0511
www.nw-architects.co.uk

CLIENT

COURTS DEVELOPMENTS

PROJECT

1-2 High Street