
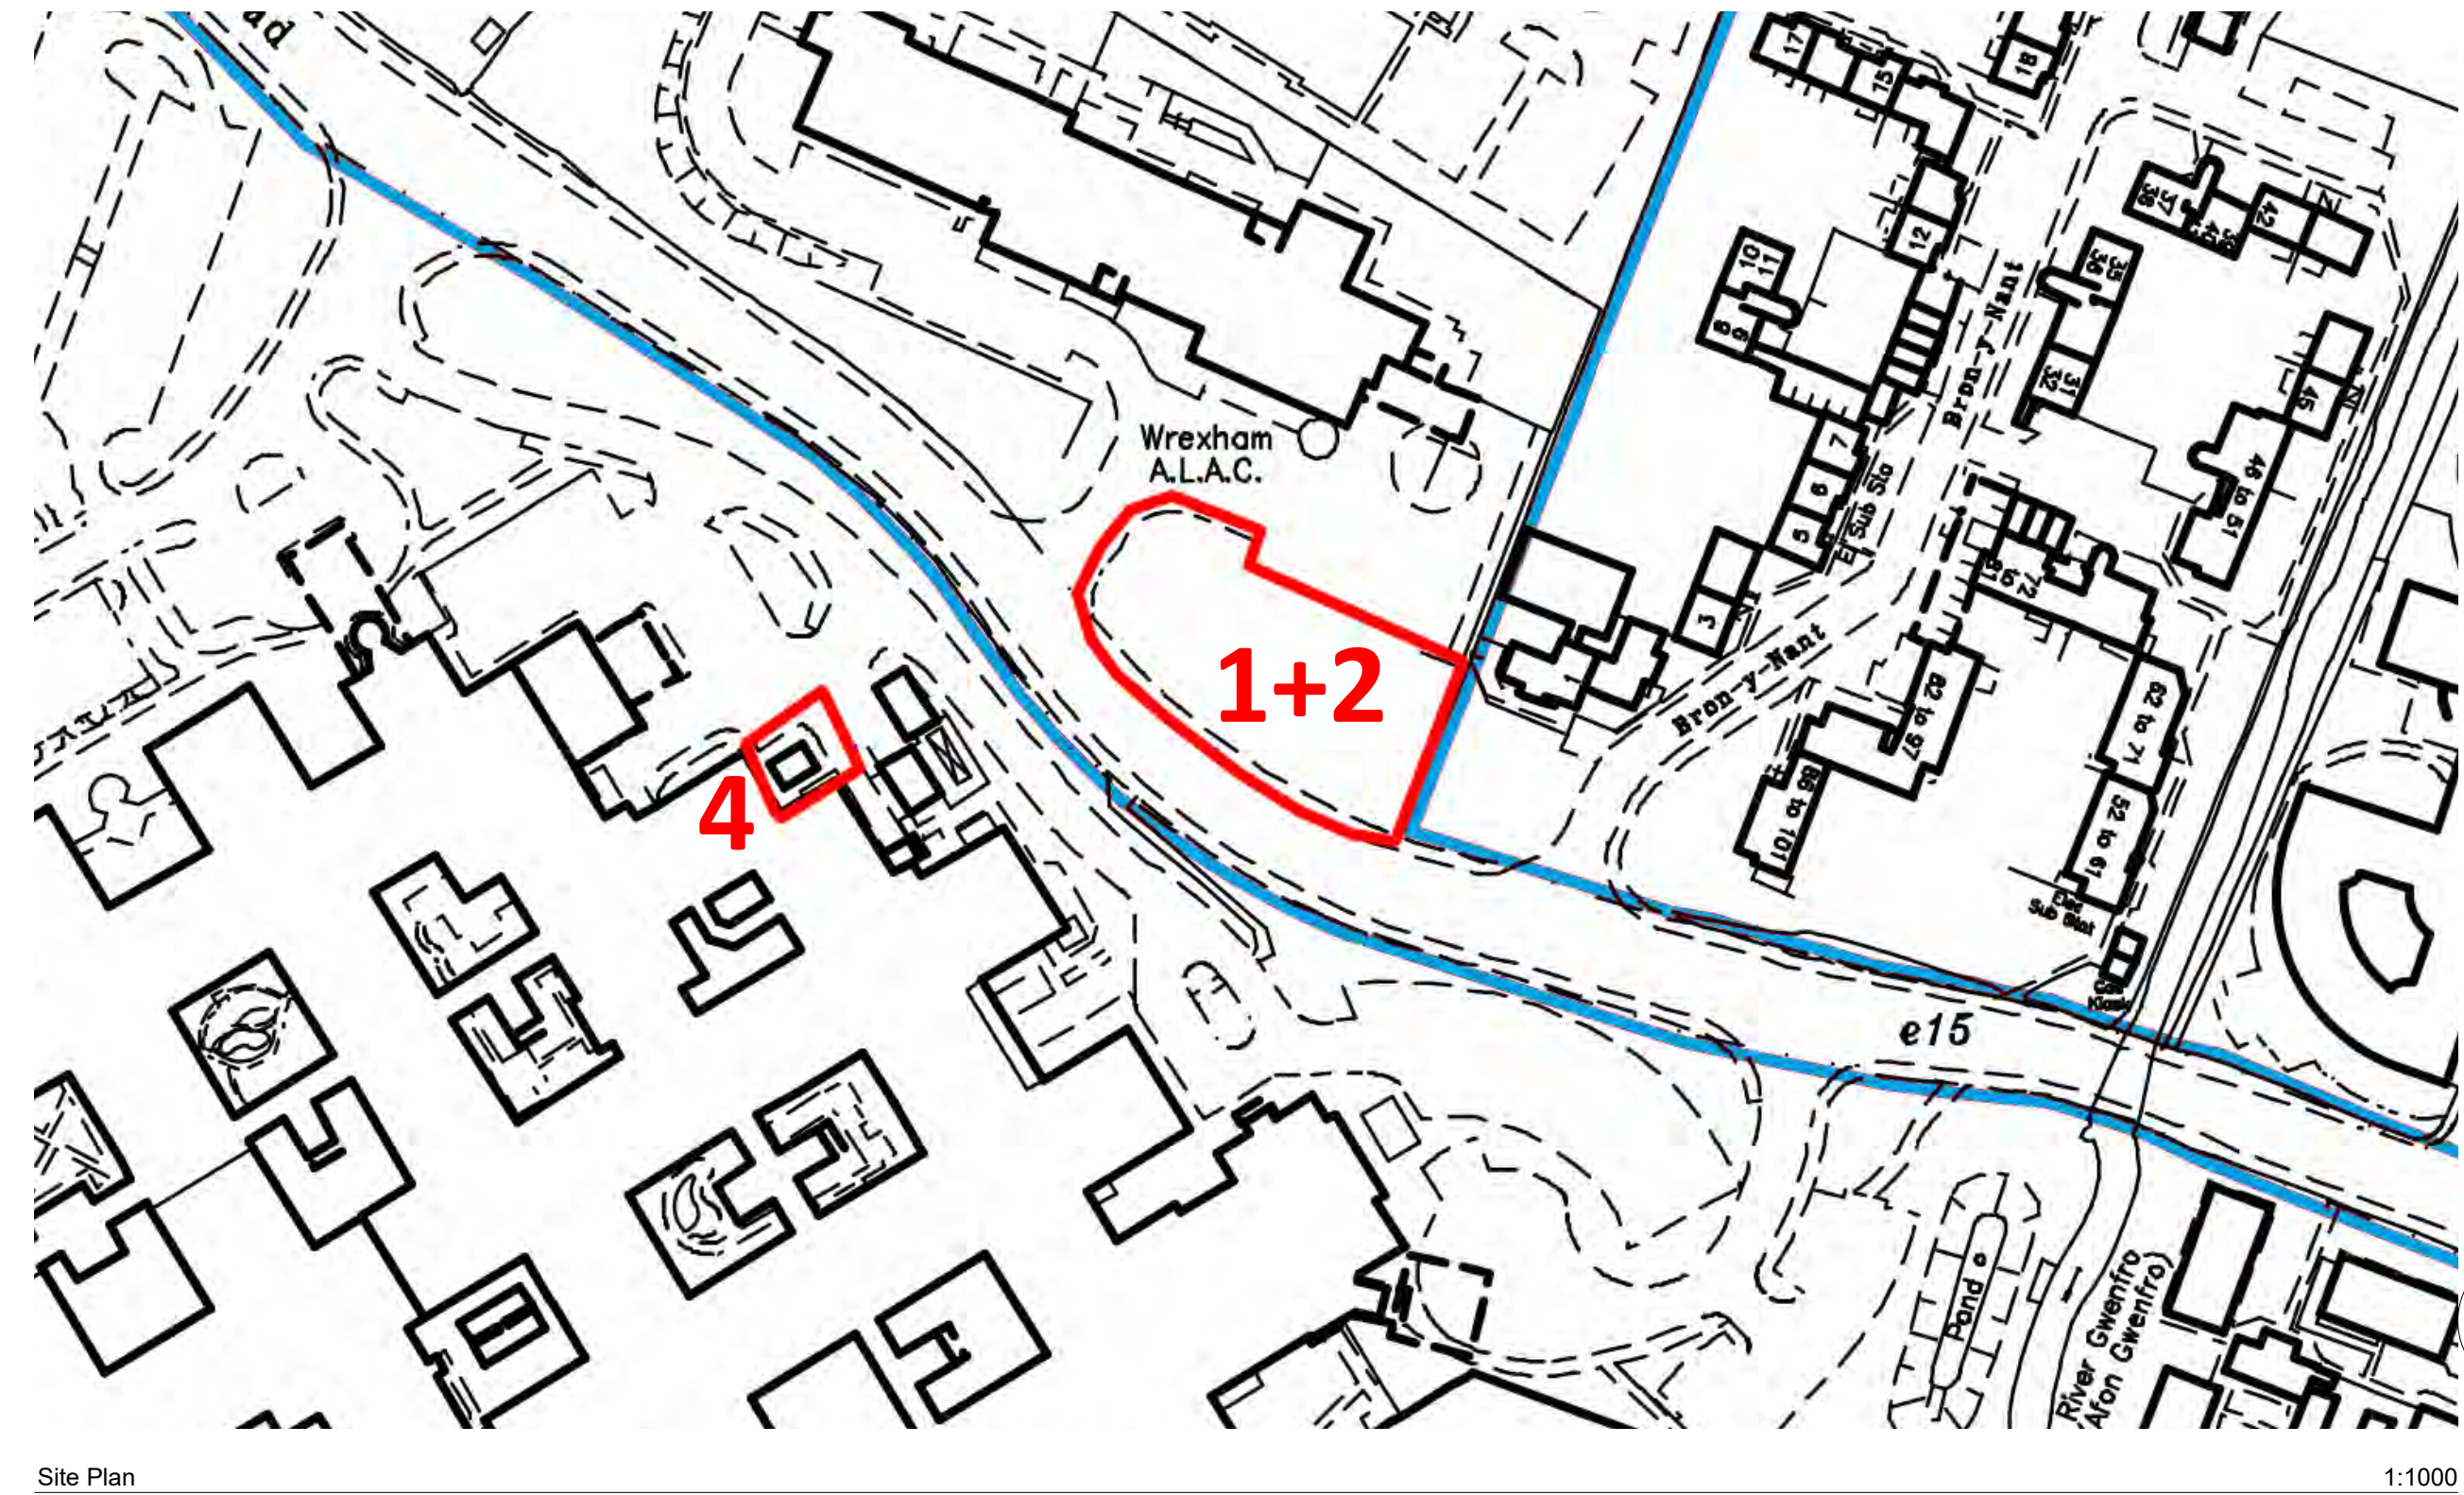


- KEY:**
- RED FACING BRICKWORK, BLUE ENGINEERING BRICKWORK BELOW DPC.
 - POLYESTER POWDER COATED DOORS DARK GREY.
 - POLYESTER POWDER COATED ALUMINIUM RAINWATER GOODS DARK GREY.
 - POLYESTER POWDER COATED ALUMINIUM COPING/FLASHING DARK GREY.
 - POLYESTER POWDER COATED ALUMINIUM ACOUSTIC SCREEN DARK GREY.

	SITE AREA	INTERNAL FLOOR AREA	EXTERNAL FLOOR AREA
SUBSTATION 1 + 2	1360m ²	28m ²	37m ²
SUBSTATION 3	401m ²	28m ²	37m ²
SUBSTATION 4	115m ²	38m ²	52m ²
SUBSTATION 5	412m ²	28m ²	37m ²

Notes
Check all dimensions on site. Do not scale from this drawing
Report any discrepancies and omissions to HLM Architects
This Drawing is Copyright ©

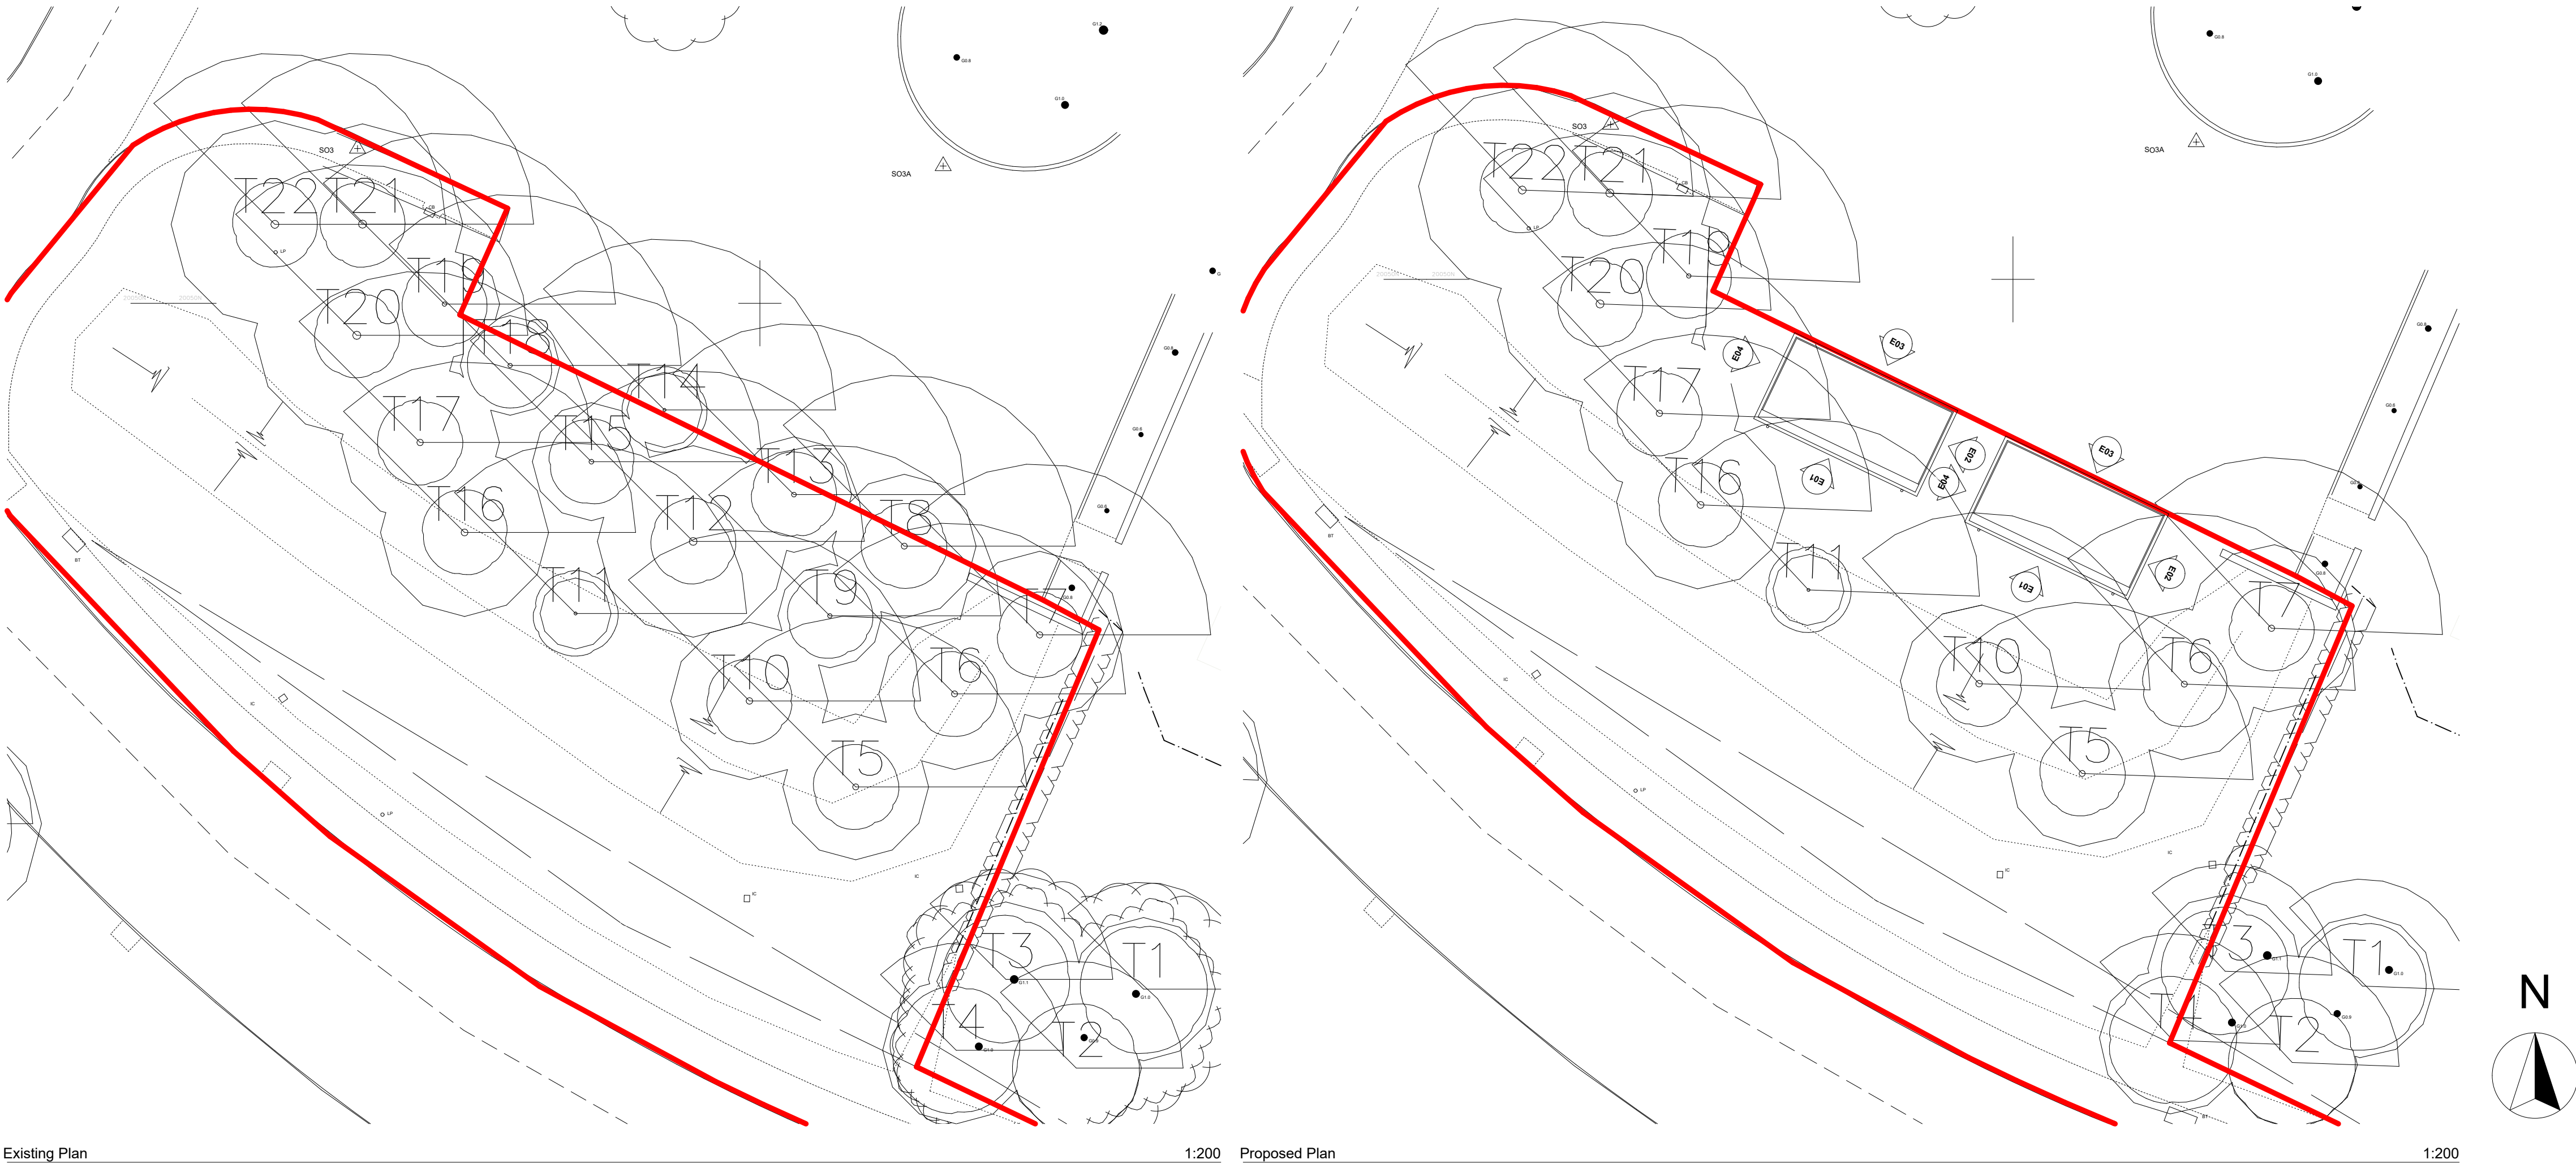

Could you do another site layout of the trees to be removed & show them dotted in red

Can you omit the red line to the other sites as its a liitle confusing when they are going to be separate applications for each substation, could probably loose the numbers as well.

Pos	ISSUE FOR PLANNING APPROVAL	11/08/21	HW	HLM
Rev	Description	Date	By	Chk
Revisions				Suitability
Project	S0 WORK IN PROGRESS			

WREXHAM MAELOR HOSPITAL

Client



Title

SUBSTATION 1 & 2 - INTAKE & HB HV - PLANNING APPLICATION

Drawing No: WMHCW-HLM-V01-XX-DR-A-P01 0001

Scale @ A1	Drawn
As Drawing	BC
Date	Checked
10/08/2021	HLM



© HLMArchitects
2nd Floor
The Ruskin Building
Tudor Square
Sheffield S1 2LA

www.hlmarchitects.com
T. +44 (0) 114 263 9600
F. +44 (0) 114 263 9650
sheffield@hlmarchitects.com

