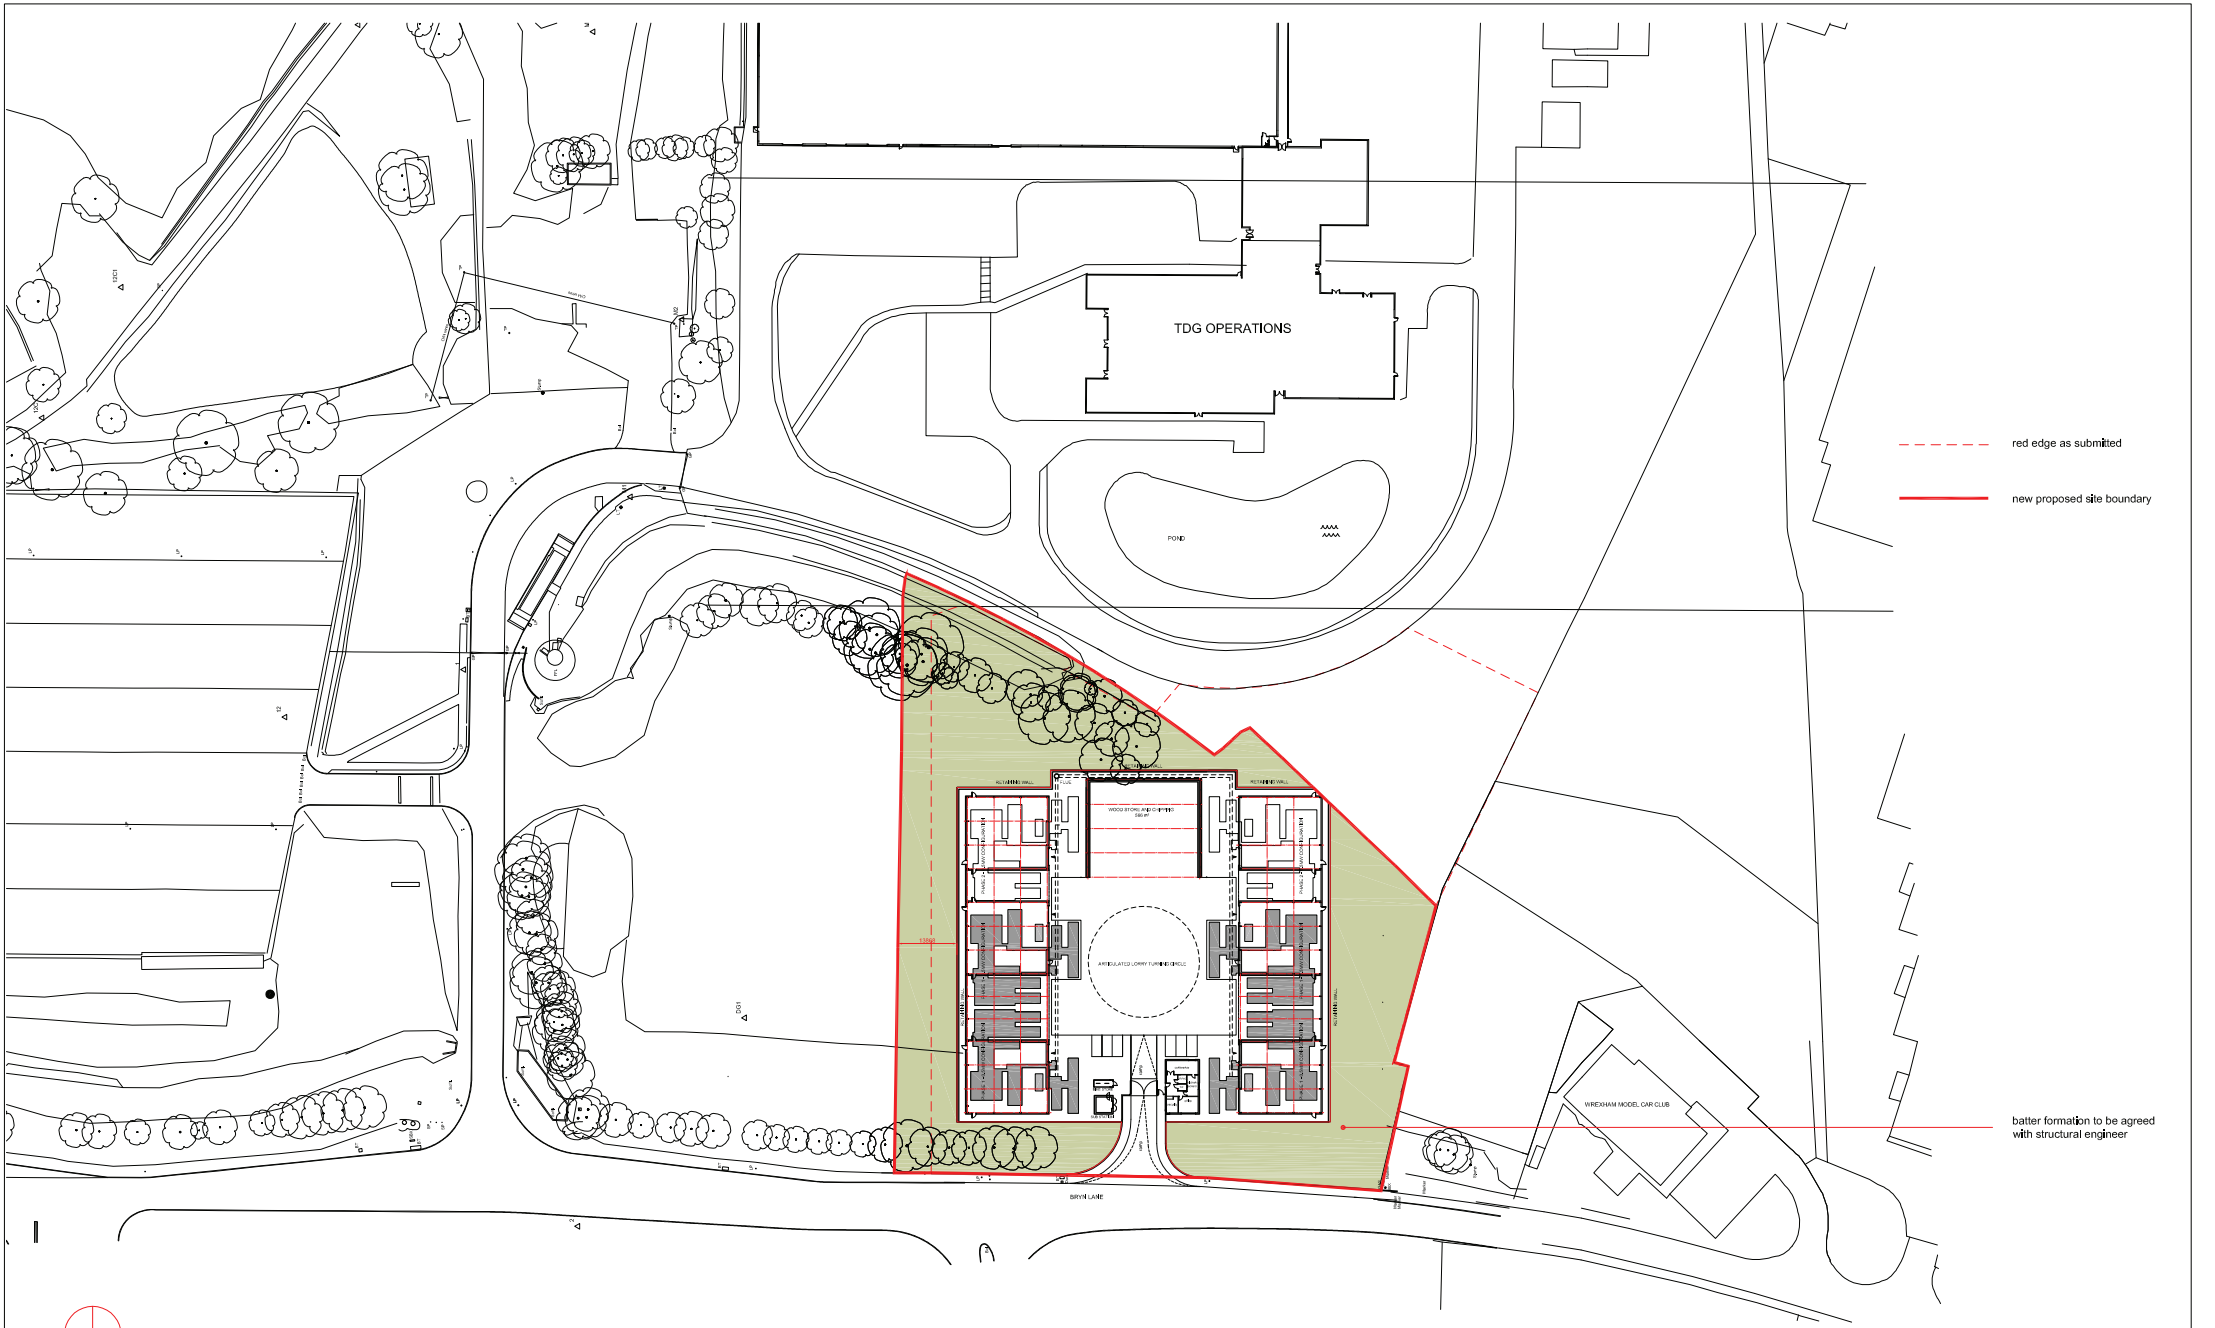

FOR COMMENT ONLY

red edge plan - propsed 1:1250 revised red line boundary

antonio garcia architecture		JOB/CLIENT: GREEN PLAN ENERGY LTD WREXHAM INDUSTRIAL ESTATE BIOMASS PLANT	
ARCHITECTURAL DESIGN & VISUALISATION		DRAWING TITLE: RED EDGE PLAN - PROPOSED	
TEL: 0151 708 5159 e: studio@agarcia.uk	suite 7 Hahnemann House 42 Hope Street Liverpool L1 9HW	SCALE: 1:1250@ A3 DRAWN BY: JL DATE: 23.11.2009 CHECKED BY: AG COMPUTER DRAWING REF: PROJECT No. L0.5636	DRAWING No. SK-1251-A

DO NOT SCALE THIS DRAWING. VERIFY ALL DIMENSIONS ON SITE. ANY DISCREPENCIES TO BE REPORTED TO ANTONIO GARCIA ARCHITECTURE