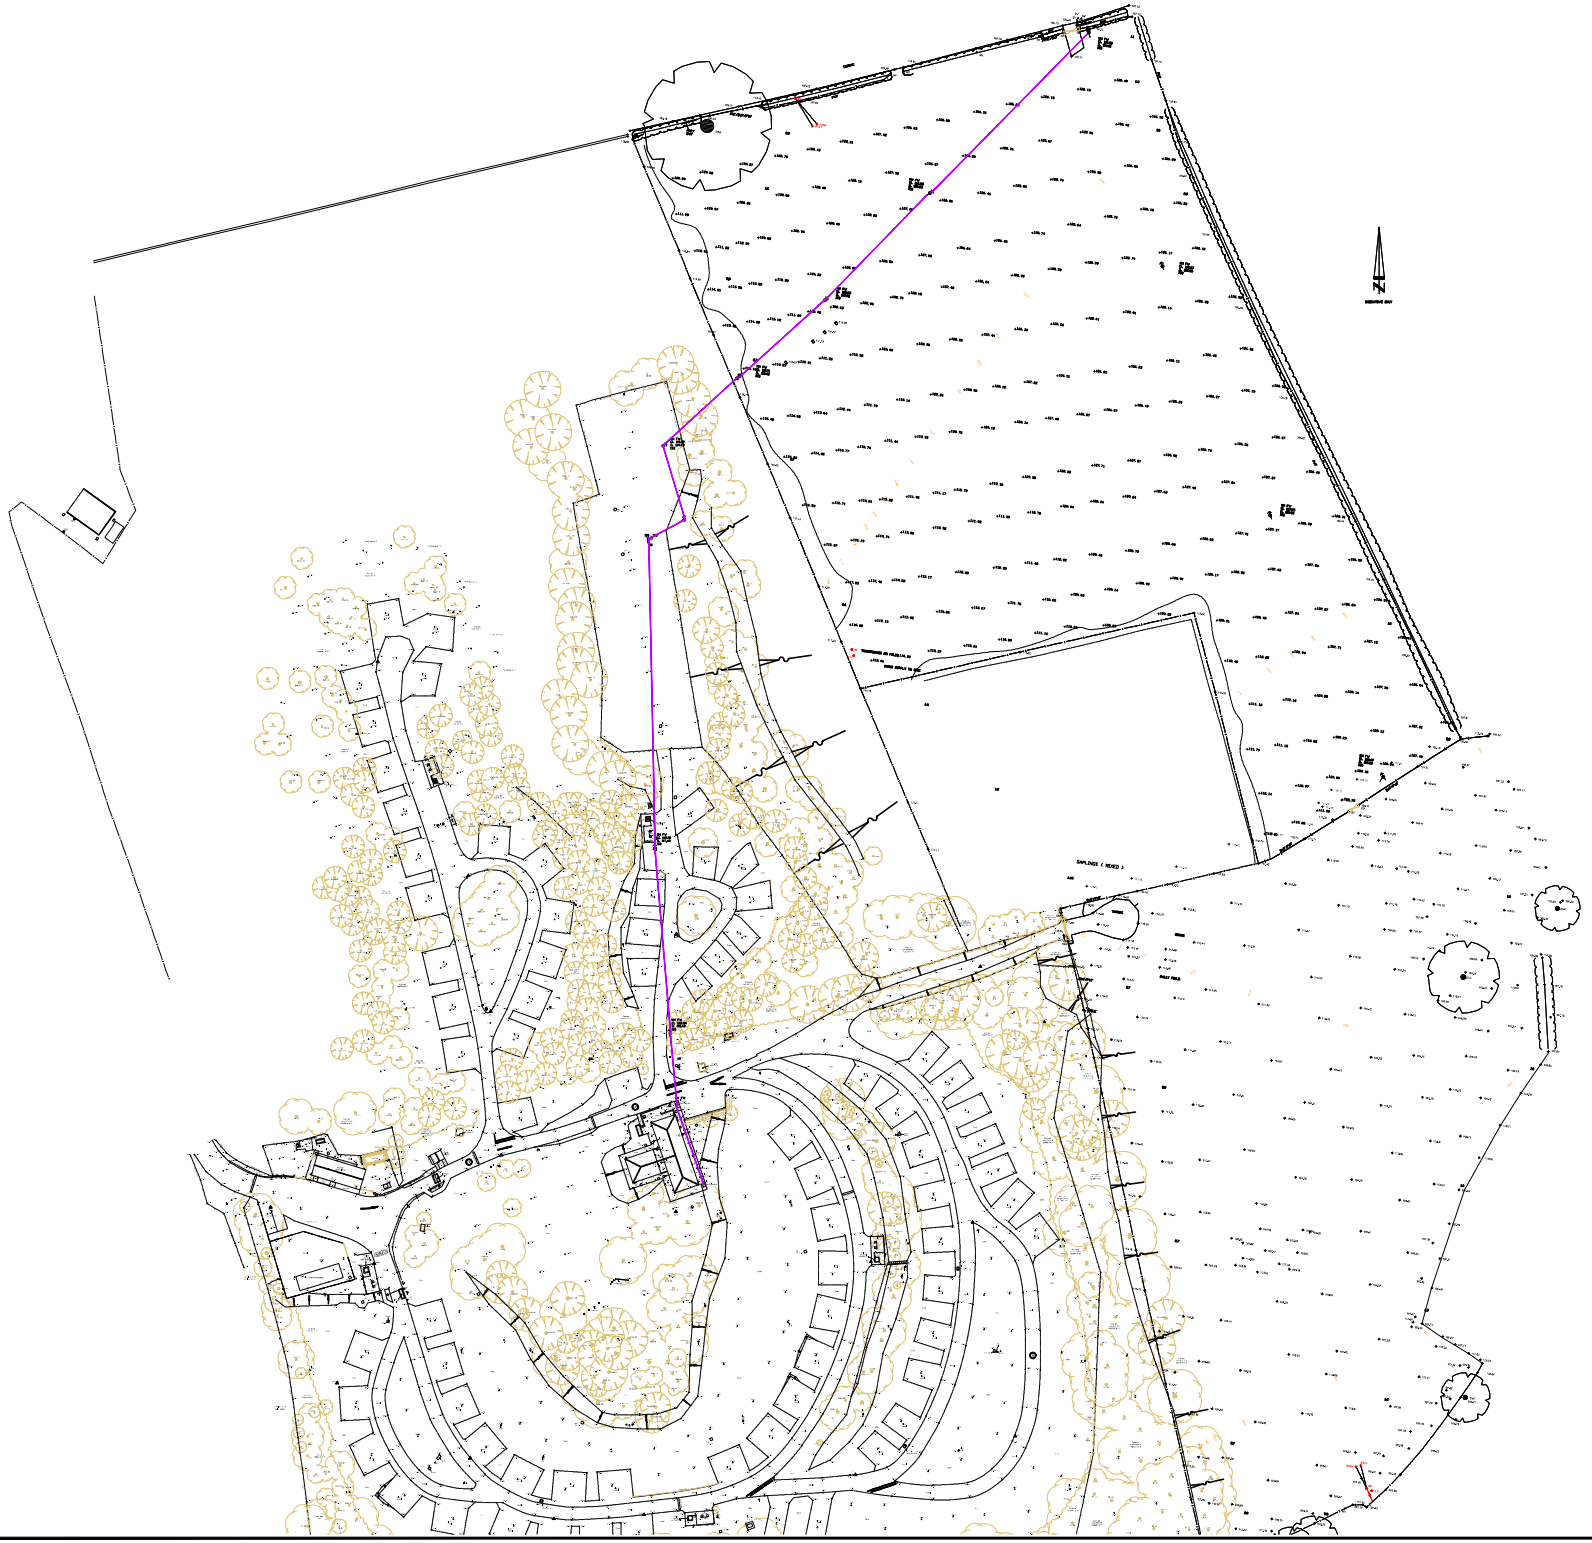


This drawing is the copyright of The Caravan Club Limited and may not be reproduced in whole or in part without its express permission, whilst information contained in this drawing is provided in good faith, being based on available records and where applicable electro-detection techniques in location of underground electrical & telephonic services, The Caravan Club Limited will not be held responsible for errors in or omissions from the information shown. Contractors and other parties must satisfy themselves as to the accuracy and completeness of the information shown, to determine the existence of services which might cause danger, be damaged or need replacement in connection with their engagement.

Status: AS BUILT

Revisions:

Project/Site: LADY MARGARETS PARK
CAMC SITE

Title: AS BUILT
WITH MAIN DRINAGE RUN

Drawing No: LMP-2021-S-180

Date: JAN 20

Drawn By:

Checked By:

Scale: 1:500@A0

CAD File: LMP-2021-S-180

CARAVAN AND MOTORHOME CLUB

Estates Department, East Grinstead House, East Grinstead, RH19 1UA
Tel: 01342 326772