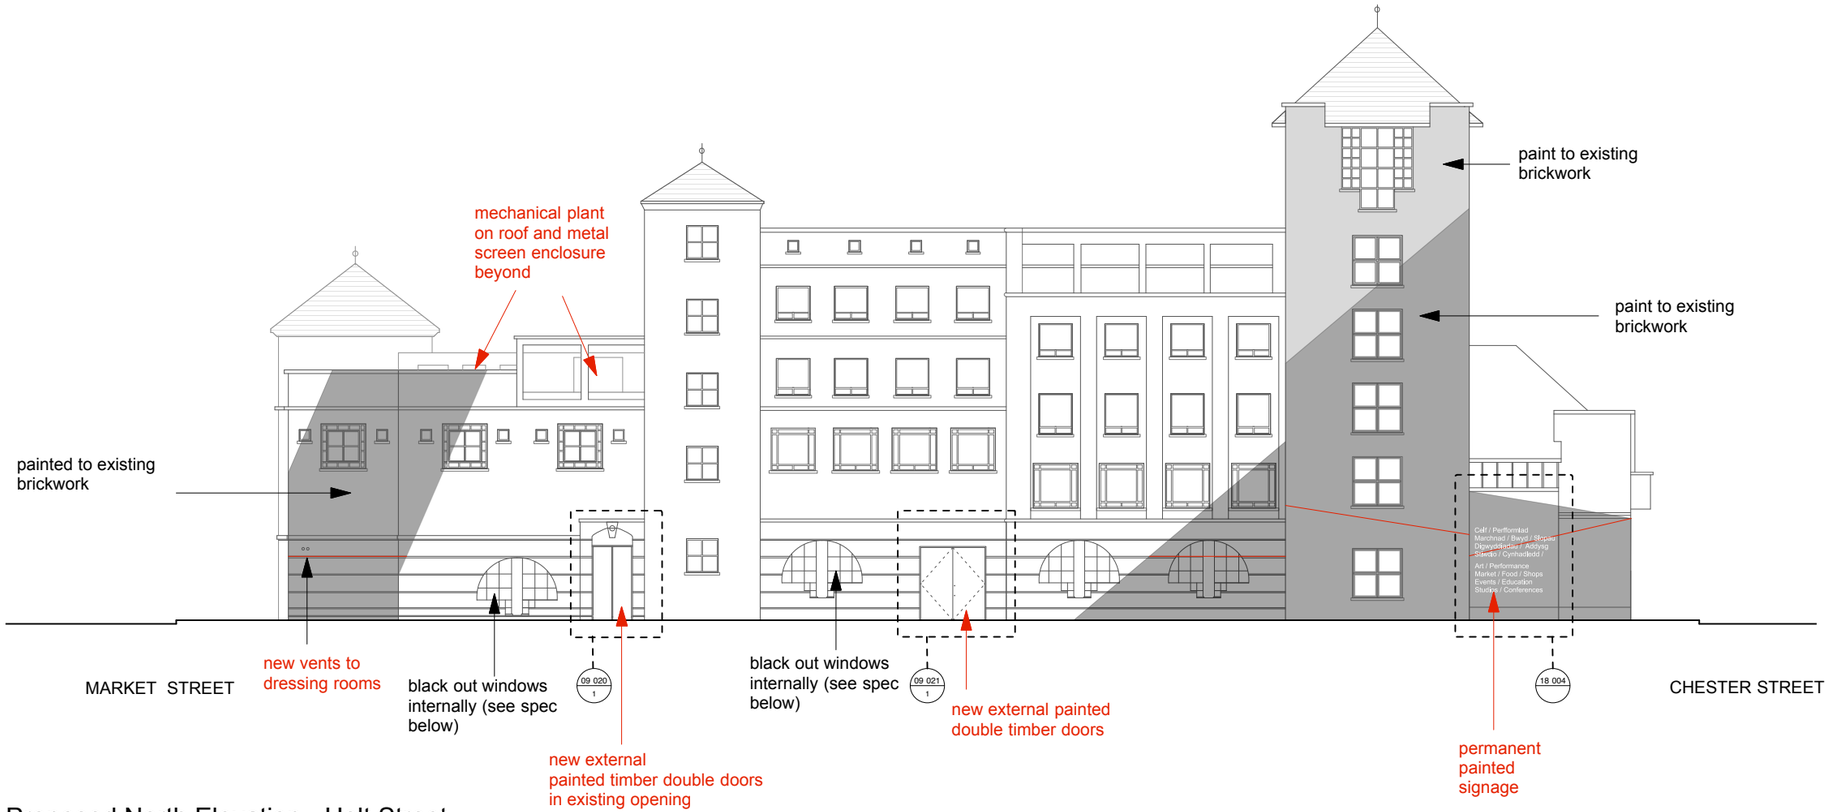

Proposed North Elevation - Holt Street

KEY

Paint external brickwork/masonry wall with Keim Royal Mineral Paint as per manufacturer's recommendations (Colours 9008 dark grey, Colour 30 light grey). Ensure all window reveal, cills and associated items are also painted.

Respray all external mesh screens as noted on drawings to match the colour of the paint.

Apply Avery Dennison® Facade Film to all window frames within areas of facade that are painted. Allow for colour change between painted/existing brickwork as illustrated on drawings

Area below red line to be treated with "Keim Anti-Graffiti Wax Coating 694" by Keim as per manufacturer's recommendations.

Block out film WFC-BO by the Window Film Company (or similar) to be applied internally to windows as noted on drawing

Refer to signage package for information on External Signage.

NOTE:
Remove all existing signage and market advertising on external signage

status **For Tender**

revisions

-	27.11.2015 Issued for planning
A	15.01.2016 Minor amendment to paint treatment
B	06.07.2016 Amendments to notes and omission of Art Window Display.
C	04.11.2016 Issued for tender
D	04.01.2017 Issued for planning approval. Changes identified in red.
E	24.01.2017 Minor amendment to location of paint

Notes:
1. Do not scale from this drawing.
2. All dimensions to be checked on site by contractor and such dimensions to be his responsibility.
3. Report all drawing errors and omissions to the architect.

ARCHITECTS
25 Links Yard. Spelman St. London E1 5LX
tel 020 7539 3686
fax 020 7539 3687
mail@featherstoneyoung .com
www.featherstoneyoung .com
FeatherstoneYoung

job **Refurbishment of People's Market**

address **People's Market, Wrexham, LL13 8BY**

dwg title **Proposed North Elevation**

scale **1:250** date **11/15**

PEP job reference | **302** drawing number | **E** revision