

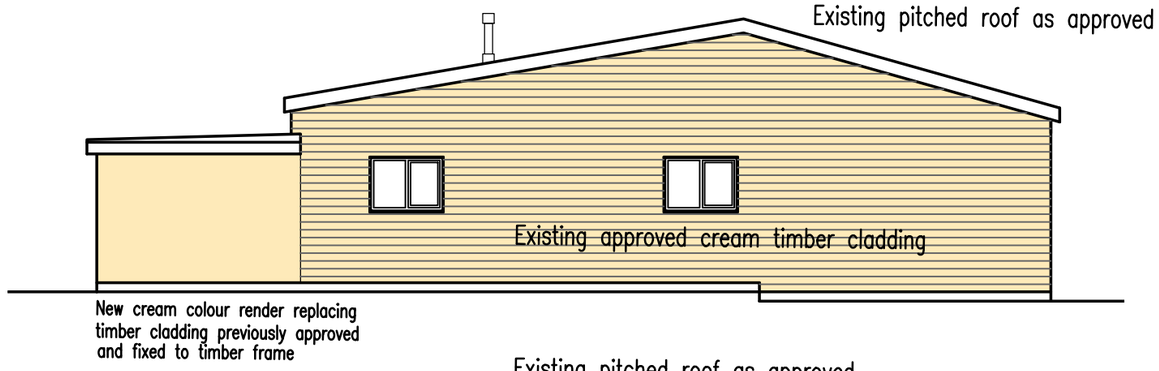


Side Elevation

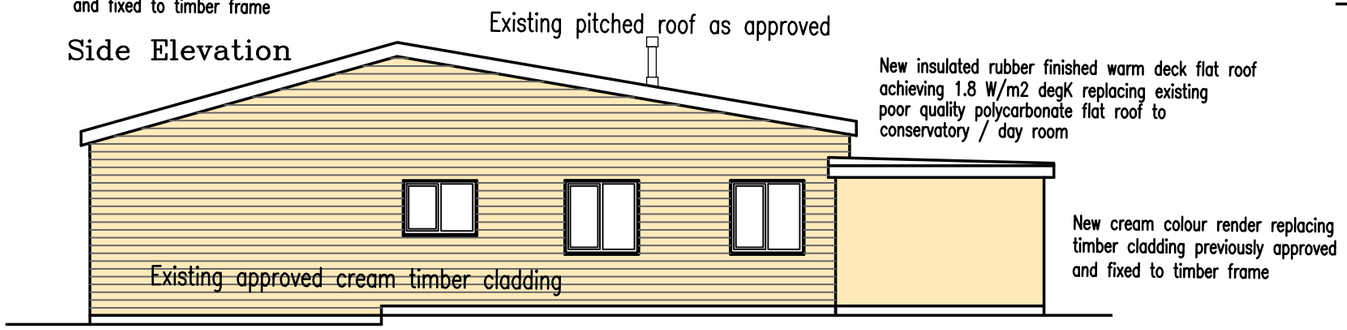


Side Elevation

Please Note – The colour of the render and cladding will be the same Shown different here to identify which areas are existing and proposed

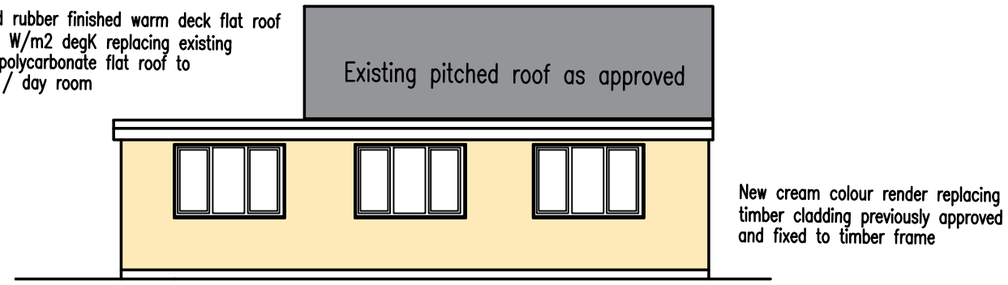


Rear Elevation

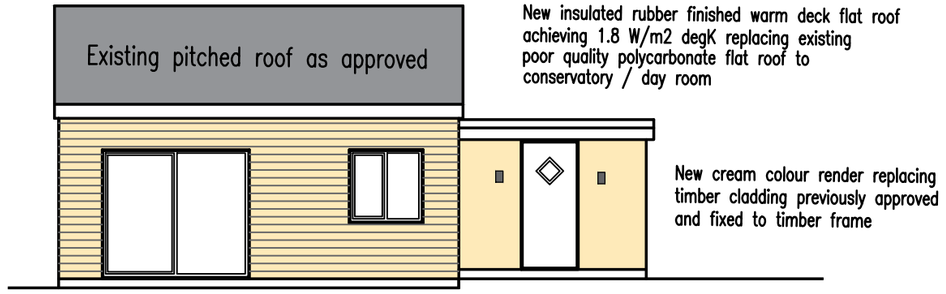

Front Elevation

Side Elevation

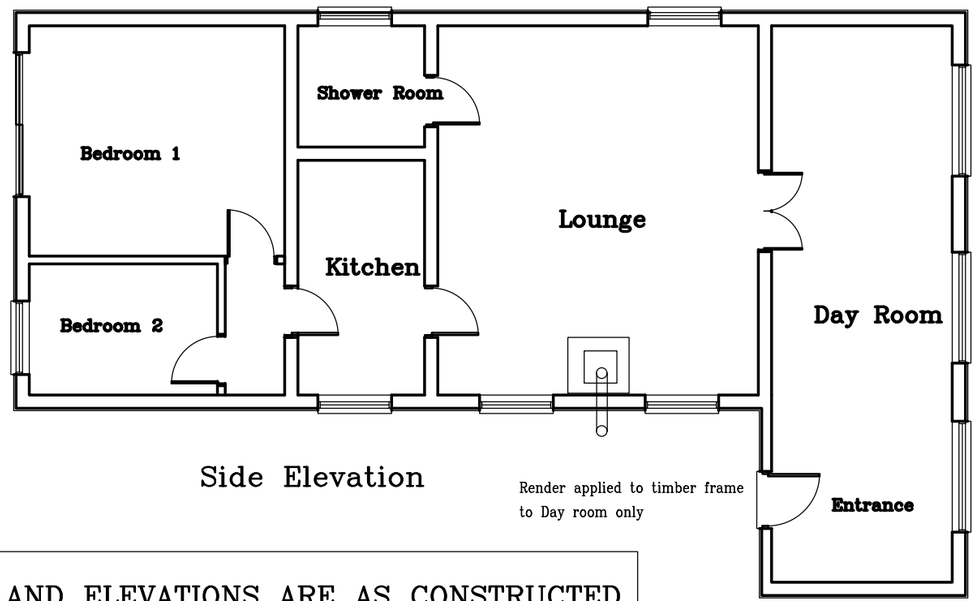

Front Elevation

Rear Elevation

Side Elevation

NOTE – PLANS AND ELEVATIONS ARE AS CONSTRUCTED.

CARTWRIGHT
ARCHITECTURAL & PLANNING SERVICES
Sunnyside, Maltkiln Lane, Hollinwood, Whixall
Whitchurch, Shropshire. SY13 2NL
E-mail – robert.cartwright6@btinternet.com
Telephone No. 01948 880123 mob 07917672498

CLIENT
Ms. Amanda Hall

CONTRACT
Facing Material change to Rosemary Barn Conversion Bettisfield. SY13 2LB

DWG TITLE:
Plans and Elevations indicating Amendments to external walls and roofing finishes

SCALE: 1:100 A3
DATE: October 2025
DWG Ref. P1 AH 2025/1