
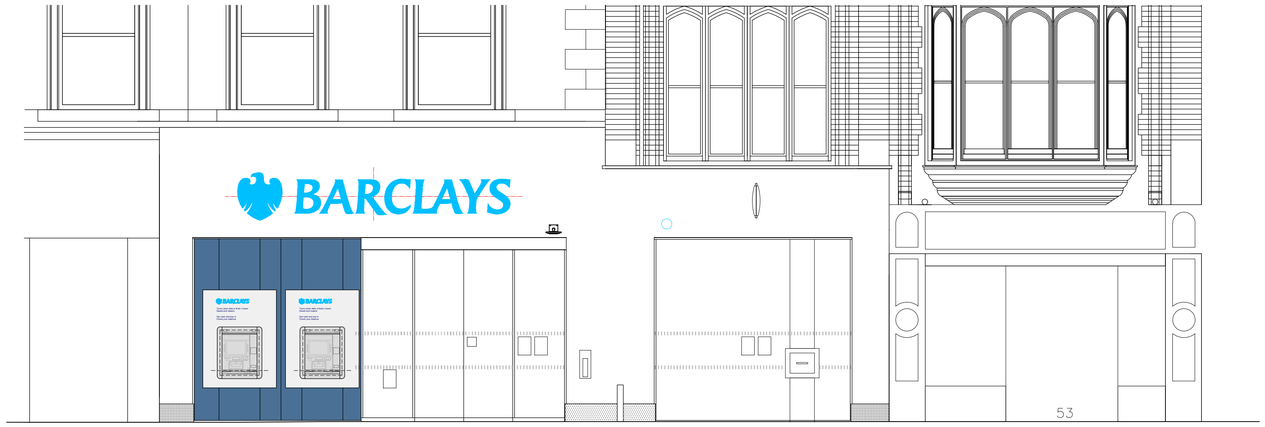


01 | EXISTING FRONT ELEVATION
SCALE: 1:50

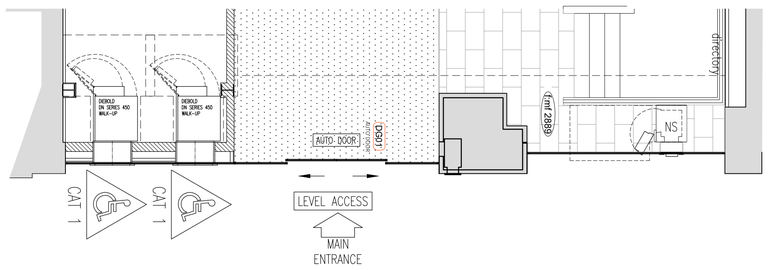

01 | EXISTING GF PART PLAN
SCALE: 1:50

SCALE BAR

0 500 1000 2500

SCALE: 1:50

REV	DATE	DESCRIPTION	ID	CH
-	14/07/26	As surveyed	ID	GW

BARCLAYS

Wates

RECORD DRAWING

DB3

CARDIFF
2 Callaghan Square, Cardiff, CF10 5BT.
T: 029 2034 2688 www.db3group.com

CLIENT
BARCLAYS BANK PLC

PROJECT
WREXHAM
51 Hope St, Wrexham LL11 1BE

TITLE
EXISTING FRONT ELEVATION

CREATION DATE	SCALE @ A1	DRN	CHK	APP	SUIT
12/01/2026	1:50	DB3			

SHEET NO.
18885 - DB3 - B01 - E1 - DR - A - 20011
PROJECT NO | ORIGINATOR | ZONE | LEVEL | TYPE | ROLE | NUMBER

REVISION
-

© COPYRIGHT: ALL RIGHTS RESERVED.
THIS DRAWING MUST BE READ IN CONJUNCTION WITH ALL OTHER RELEVANT DRAWINGS AND INFORMATION.
ANY DISCREPANCIES MUST BE REPORTED TO DARNTONB3 IMMEDIATELY.
THIS DRAWING OR INFORMATION MUST NOT BE USED FOR CONSTRUCTION UNLESS EXPRESSLY ISSUED FOR CONSTRUCTION.

DO NOT SCALE FROM THIS DRAWING. WORK ONLY TO THE PRINTED DIMENSIONS.