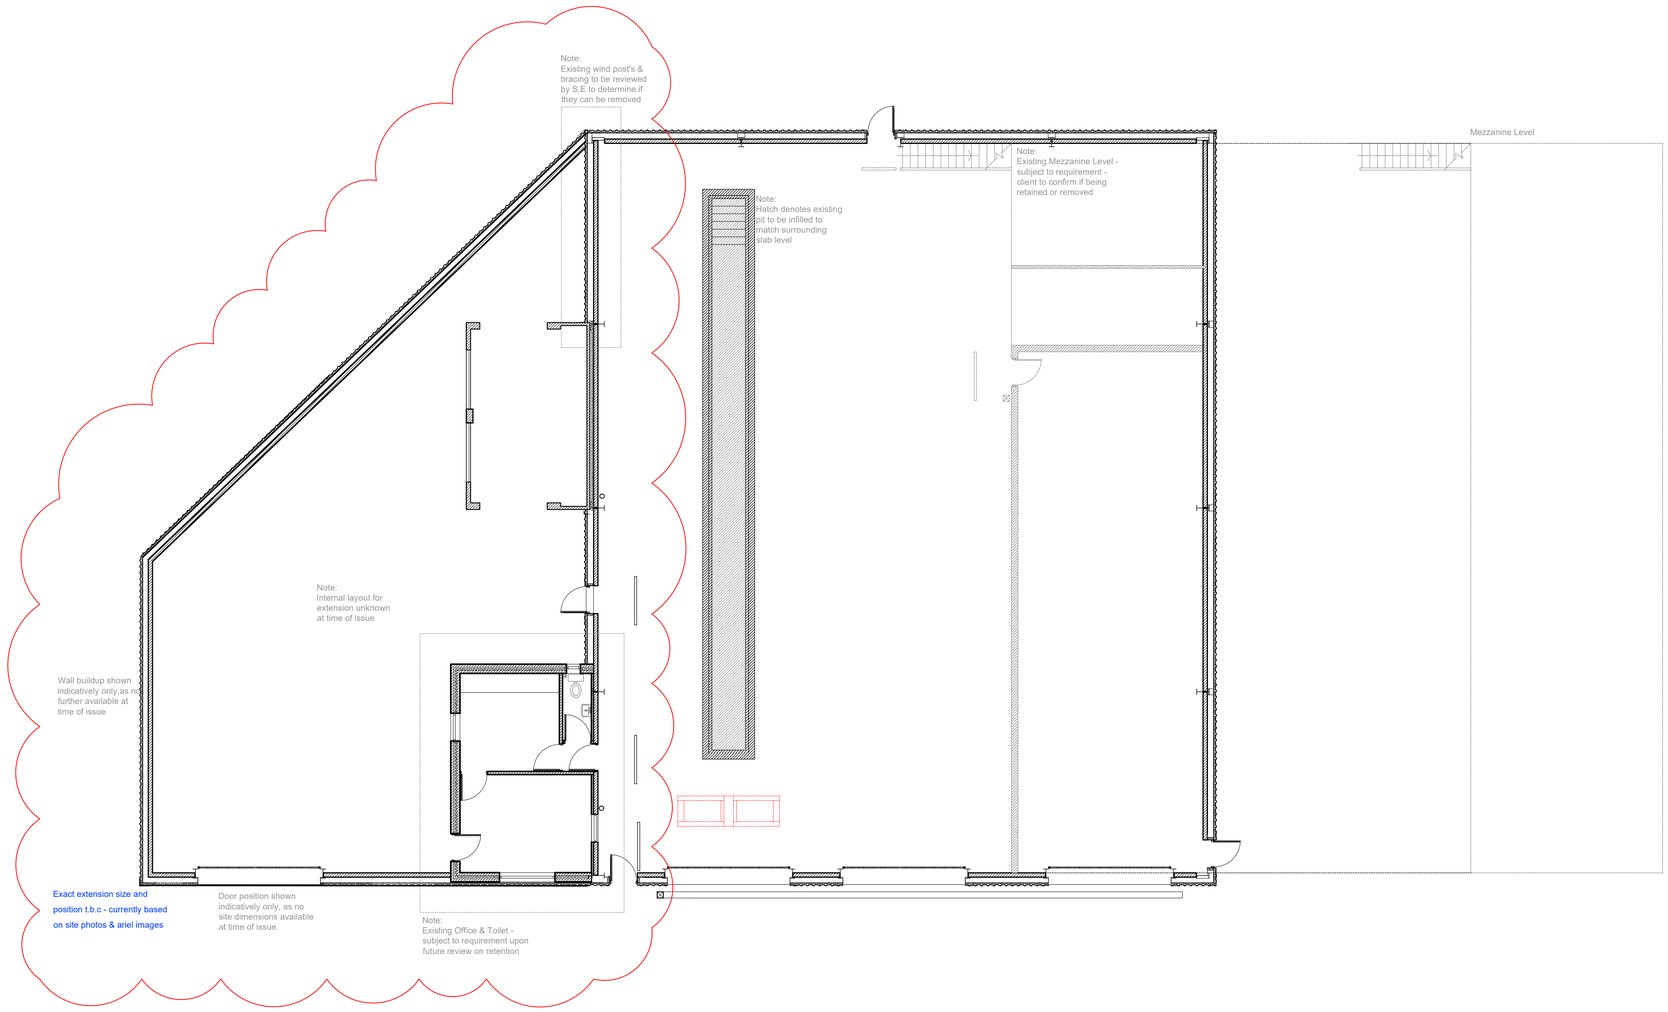



# Workshop - Ground Floor Demolition Plan

Scale 1 : 100

1m 10m

## GENERAL NOTES:

ALL DIMENSIONS ARE TO BE CHECKED ON SITE WITH ANY DISCREPANCIES REPORTED TO THE ARCHITECT PRIOR TO THE WORKS BEING CARRIED OUT.

ALL WORKS ARE TO BE IN ACCORDANCE WITH THE PLANNING APPROVAL AND ANY SUBSEQUENT APPROVED LOCAL AUTHORITY PLANNING CORRESPONDENCE INCLUDING DRAWINGS, DOCUMENTS AND REPORTS.

ALL WORKS ARE TO COMPLY WITH THE BUILDING REGULATIONS, BRITISH STANDARDS, CODE OF PRACTICE, AND ANY LOCAL STATUTORY REQUIREMENTS.

ALL WORKS ARE TO COMPLY WITH CURRENT HEALTH AND SAFETY LEGISLATION, H.S.E. RECOMMENDATIONS/GUIDANCE AND THE CURRENT C.D.M. REGULATIONS.

THIS DRAWING IS TO BE READ IN CONJUNCTION WITH MARTIN SPENCER ARCHITECUTRE GENERAL ARRANGEMENT DRAWINGS, TOGETHER WITH RELEVANT DETAILED DRAWINGS AND SPECIFICATIONS.

FOR ALL STRUCTURAL WORKS REFER TO THE STRUCTURAL ENGINEERS INFORMATION.

FOR ALL MECHANICAL AND ELECTRICAL WORKS REFER TO THE MECHANICAL AND ELECTRICAL ENGINEERS INFORMATION.

FOR ALL ABOVE GROUND DRAINAGE WORKS REFER TO THE PUBLIC HEALTH ENGINEERS INFORMATION.

ALL PRODUCTS SPECIFIED ARE TO BE INSTALLED STRICTLY IN ACCORDANCE WITH THE MANUFACTURERS RECOMMENDATIONS, SPECIFICATION AND DETAILS.

COPYRIGHT REMAINS WITH MARTIN SPENCER ARCHITECTURE LLP

Note:
Layout based on received information, all information should check onsite prior to any construction or manufacture of new elements

---------- Denotes demolished elements

Layout is subject to full S.E review prior to any construction.

| rev | description | drwn | auth | date |
|---|---|---|---|---|
| P02 | Extension to workshop update to reflect as built - based on images and satellite images, as clouded | NLM | NLM | 05.06.25 |
| P01 | First Preliminary Issue | NLM | NLM | 09.04.25 |

DO NOT SCALE OFF THIS DRAWING

MARTIN SPENCER ARCHITECTURE
CIAT

www.ms-architecture.com
info@ms-architecture.com

Clarence Arcade, Stamford St W, Ashton-under-Lyne OL6 7PT
**Tel:** 07725 053293

CLIENT
MRT & Ty Eco

PROJECT
Five Crosses, Coedpoeth, Wrexham LL11 3RD

DOCUMENT NAME
349-MSA-ZZ-00-DR-A-20-106

DESCRIPTION
Workshop - Ground Floor Demolition Plan

| REVISION | SCALE @ A1 |
|---|---|
| P02 | 1:100 |

| MSA PROJECT No. | DATE CREATED | CREATED BY | CHECKED BY |
|---|---|---|---|
| 349 | 09.04.25 | NLM | NLM |