
Drawing No. 1085/2

Revisions


Date April 2026

Scale 1 : 100


REPLACEMENT PORCH AND FRONT EXTENSION TO 21, RICHMOND ROAD, ACTON, WREXHAM, LL12 8AA

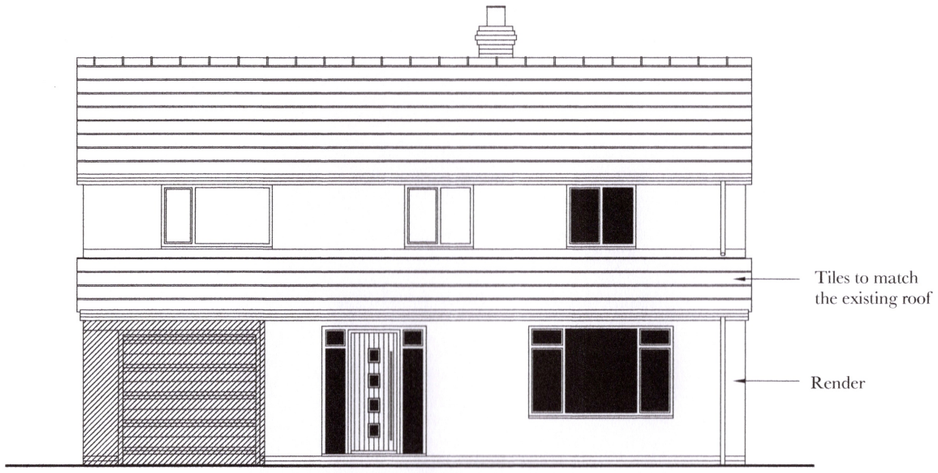

AS BUILT FRONT ELEVATION

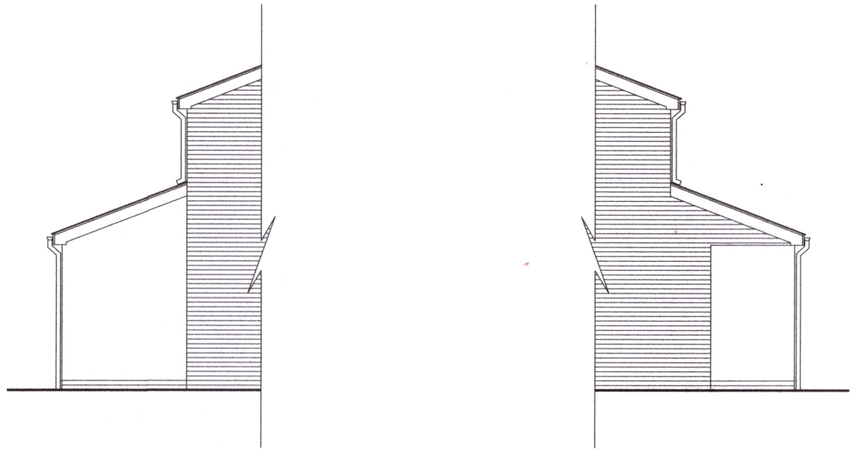

AS BUILT SIDE ELEVATIONS

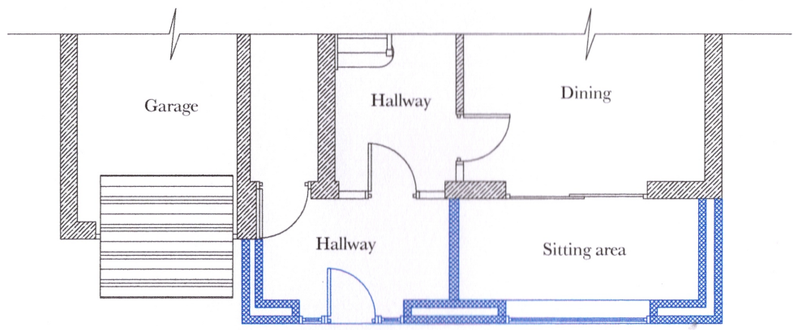

AS BUILT GROUND FLOOR PLAN

AS BUILT

0 1 2 3 4 5 6

Scale 1:100 at A3