
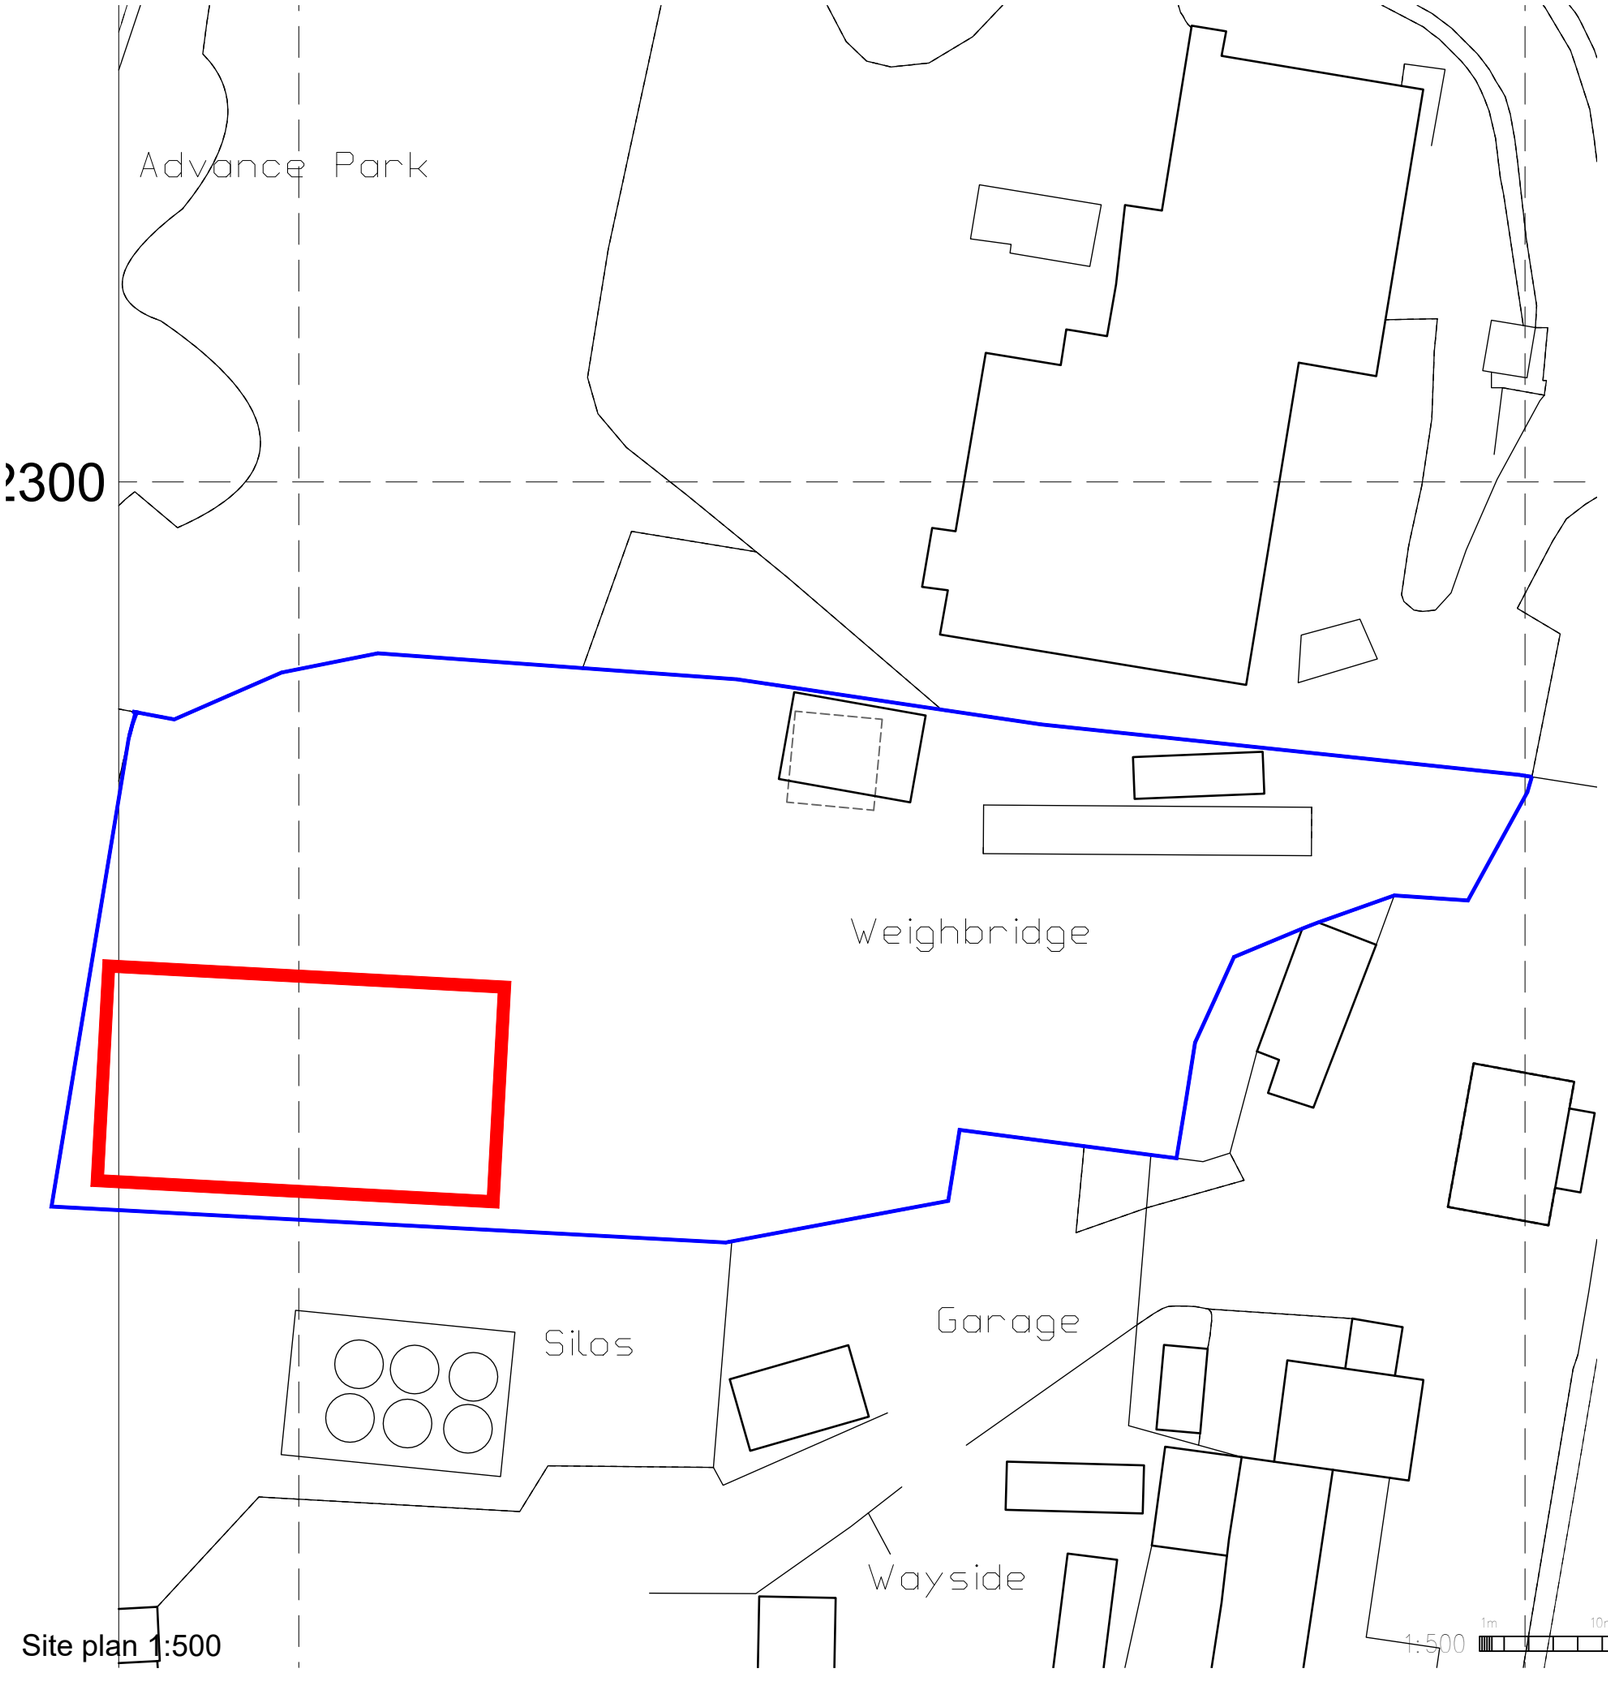


Site plan 1:500

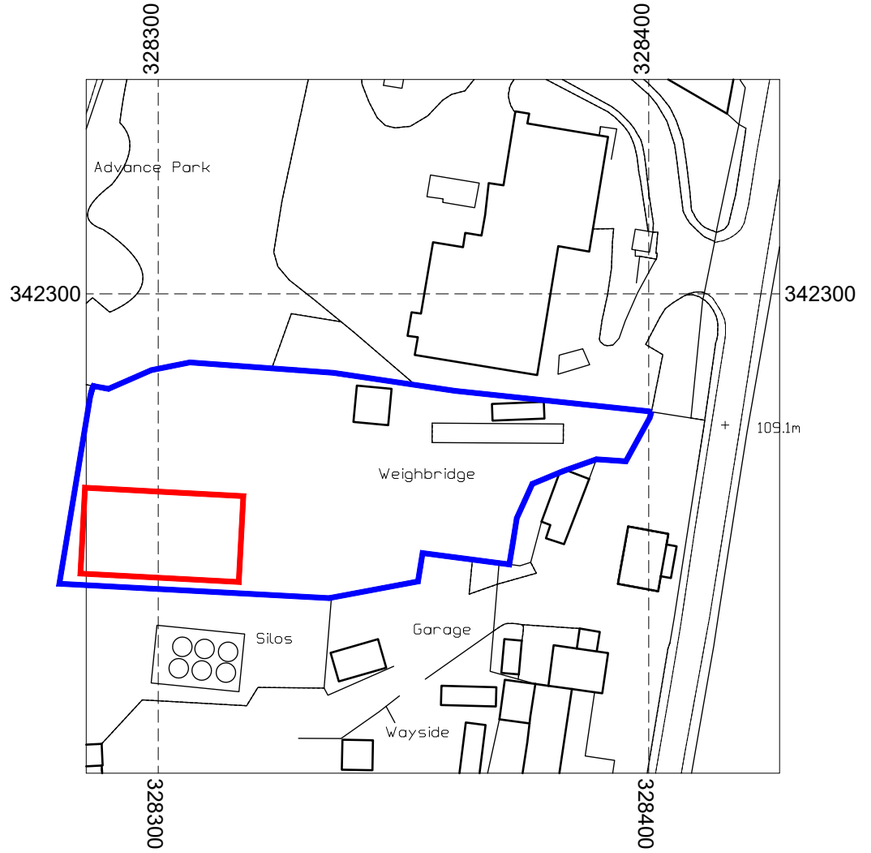

Site location plan 1:1250

1:1250 10m 20m 30m 40m 50m 60m 70m 80m 90m 100m

Legend

- Site boundary
- Other land in ownership

N

©Crown Copyright
and database rights
2025 OS 100047474

As Built

HDS ARCHITECTURAL SERVICES
HDS Architectural Services, The Foundry,
15 Yorke Street, Wrexham
LL13 8LW
Tel (01978) 345250
www.hdsarchitectural.co.uk

Project; Proposed Storage Unit at SOS Plant Hire, The Old Coal Yard, Park Road, Wrexham, LL14 3YP	
Title; 02- Site Plan as Existing	**Scale (A3);** 1:500/1250
Dwg No; SOP/PD/02	**Date;** 27.01.25
Revision;	