


Site plan 1:500

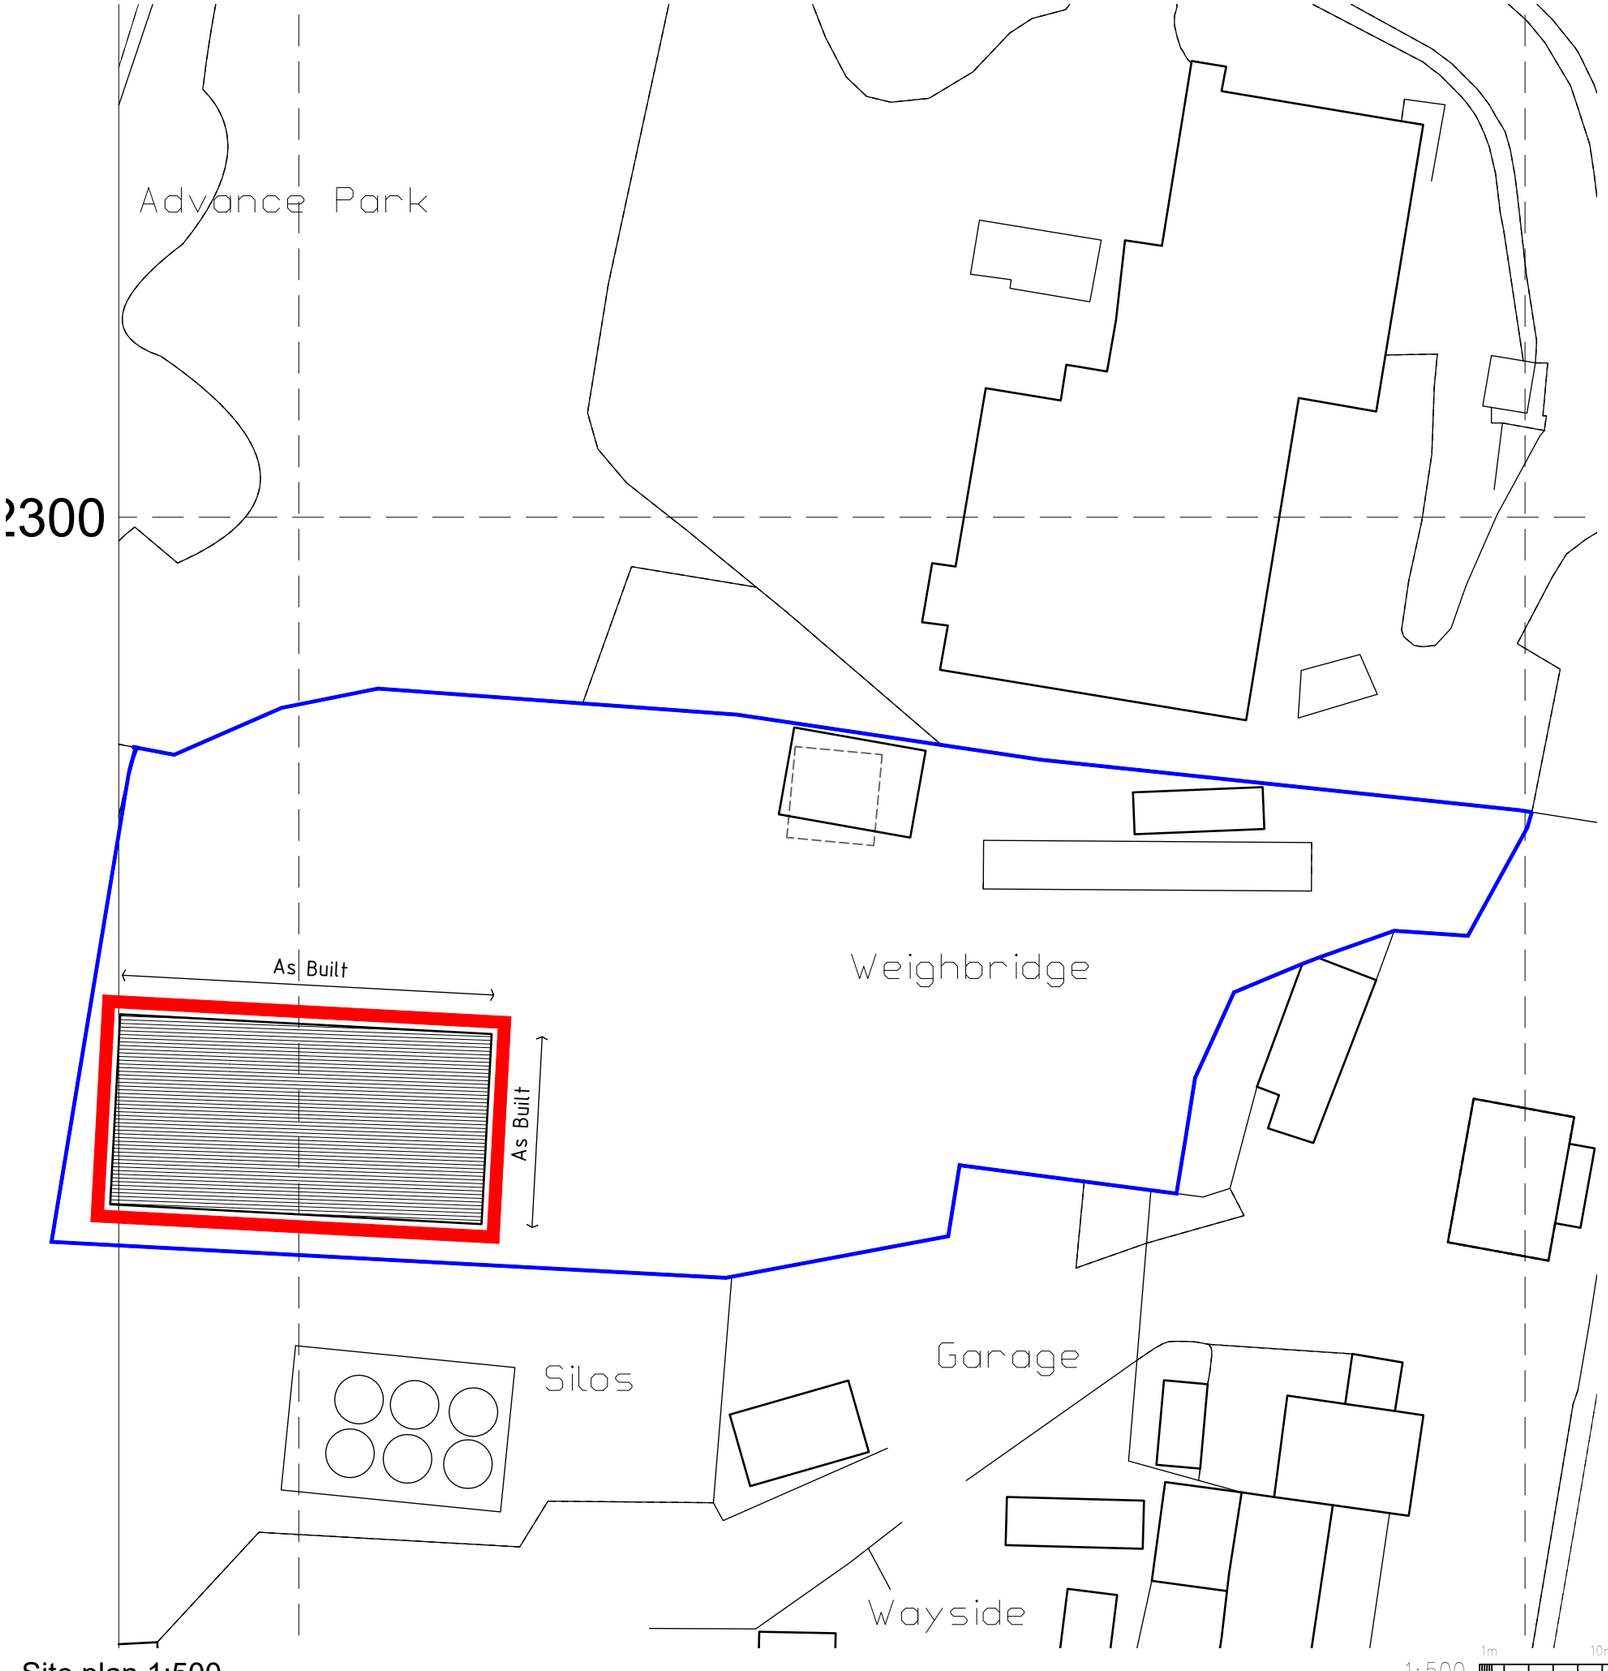

Site location plan 1:1250

1:1250 10m 20m 30m 40m 50m 60m 70m 80m 90m 100m

Legend

- Site boundary
- Other land in ownership

N

1:500 1m 10m 20m 30m 40m 50m

©Crown Copyright
and database rights
2025 OS 100047474

As Built

HDS ARCHITECTURAL SERVICES
HDS Architectural Services, The Foundry,
15 Yorke Street, Wrexham
LL13 8LW
Tel (01978) 345250
www.hdsarchitectural.co.uk

Project;
Proposed Storage Unit at SOS Plant Hire, The Old Coal Yard, Park Road, Wrexham, LL14 3YP

Title;	**Scale (A3);**
03- Site Plan as Proposed	1:500/1250
Dwg No;	**Date;**
SOP/PD/03	27.01.25

Revision;