



Site Plan 1:500

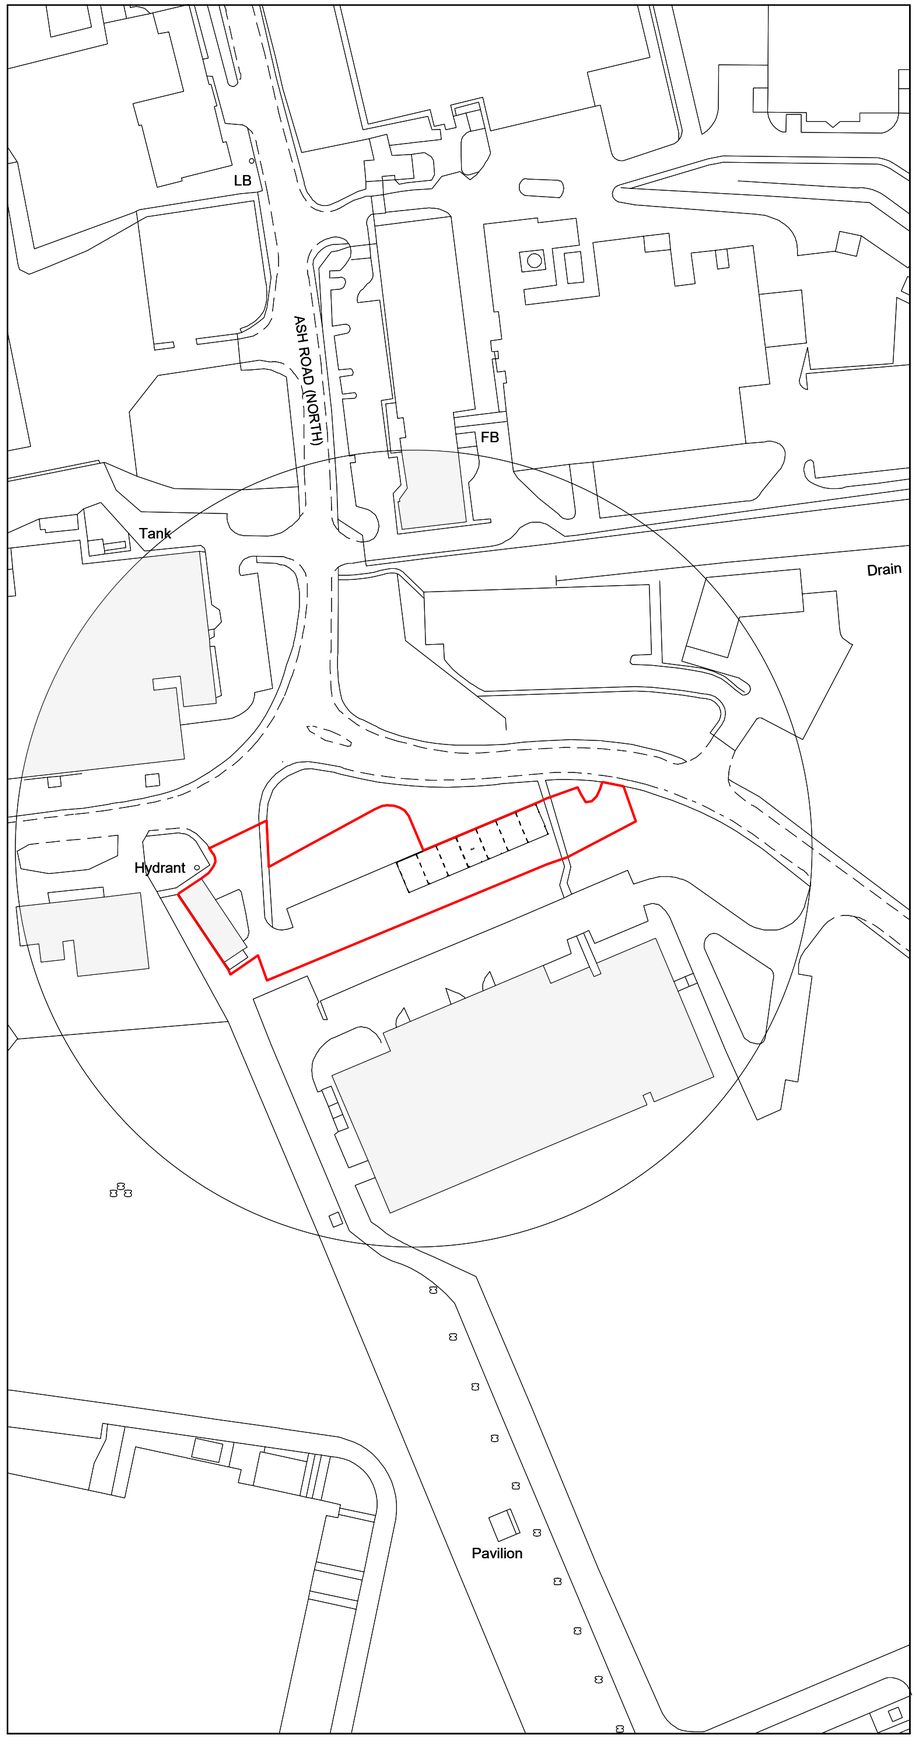

Location Plan 1:1250

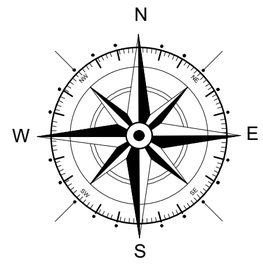

Key

- Surrounding Buildings
- Application Site
- Land owned by applicant

Rev	Date	Detail	Initial

Project:
Proposed alterations at 1 Abbey Road, Wrexham Industrial Estate, Wrexham, LL13 9RF

Title:	Scale: (A2)
As Built: Site & location Plan	1:1250 & 1:500

Drawn By:	Date:
A.Whitby	April 2026
Drawing No:	Sheet:
R147/004	1 of 1

blueprint
architectural services

partner LABC

Office 3K4,
Redwither Business Tower,
Wrexham. LL13 9XT
Tel: 01978 356500
www.blueprintarchitectural.com

© copyright all rights reserved