
©2010 Arqiva
All rights reserved. No part of this publication may be reproduced, stored in a retrieval system or transmitted in any form or by any means (Electronic, Mechanical, Photocopying, Recording or otherwise), without the prior written consent of the Company.

NOTES

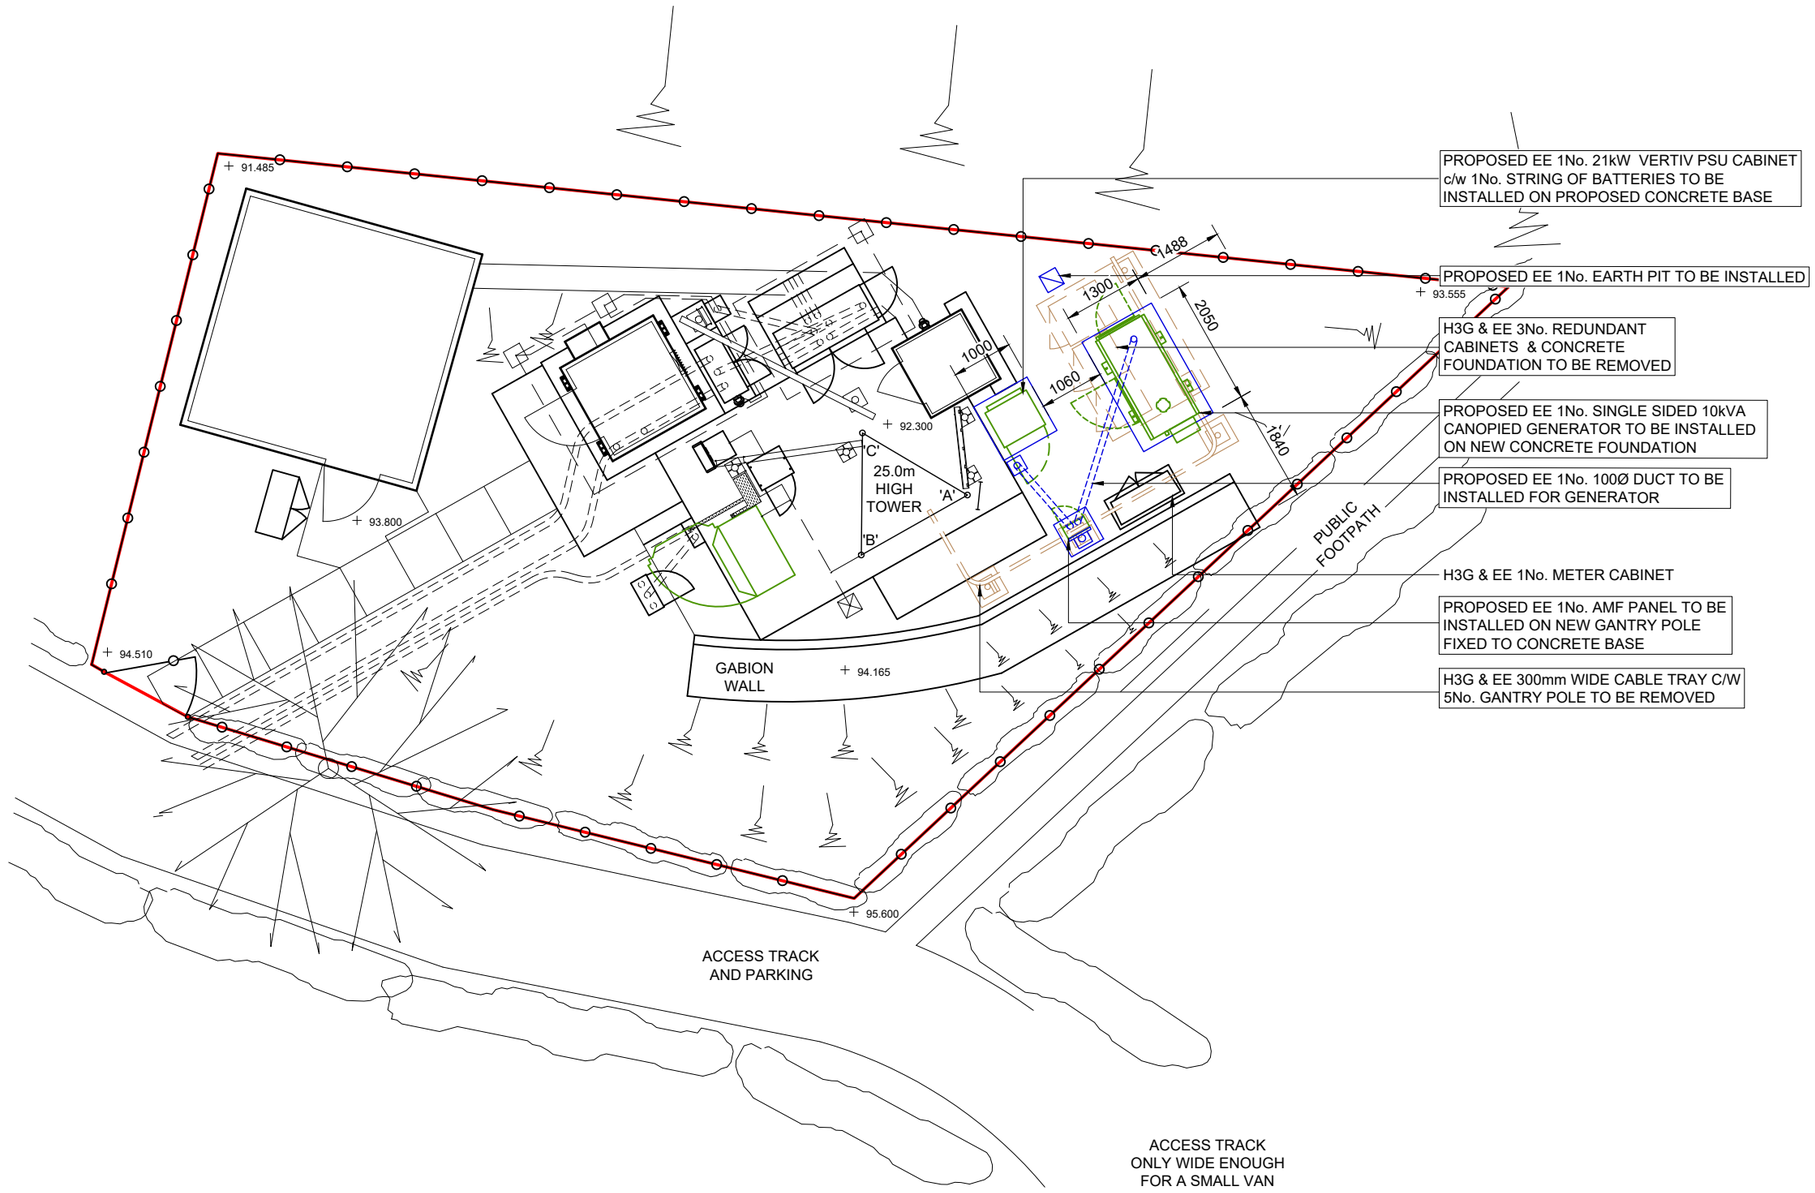

0 1m 2m 3m 4m 5m
0.5m

FEINT DETAILS INDICATE LOCATIONS RESERVED FOR OTHER PROPOSALS WHICH MAY BE THE SUBJECT OF SEPARATE APPLICATIONS

ISS	REVISION	DATE	DRN	APP
	PROJ No 12296585			
21	PLANNING	04/03/26	WHP	WHP
	PROJ No 211203			
20	AS BUILT	20/01/20	HFC	MF
	PROJ No 205833			
19	AS-BUILT	07/01/19	WHP	MF
	PROJ No 194618			
18	AS BUILT	30/07/18	PS	JY
	PROJ No 205606			
17	AS BUILT	16/07/18	DAL	MF

arqiva

Crawley Court, Winchester, Hampshire, SO21 2QA
Tel. 01962 823434, Fax. 01962 822378

SITERRA No.	12296585
PROJ No.	COL.MOD.UK.0010005
CELL No.	CLY0033

SITE No 14515
CEFN MAWR
PEN-Y-GRAIG,
FRONCYSYLLTE,
LLANGOLLEN
WREXHAM
LL20 7RT

NGR	SJ 26782 40926
OS GRID	326782 340926

TITLE
SITE PLAN
PROPOSED
H3G & EE LTD

SCALE	1:100	
DRAWN	MF	15/09/09
APPROVED	WHP	04/03/26


DRG No.	Sheet 1 of 1	Rev
14515-02-100-MD021		21

A3

©2010 Arqiva
All rights reserved. No part of this publication may be reproduced, stored in a retrieval system or transmitted in any form or by any means (Electronic, Mechanical, Photocopying, Recording or otherwise), without the prior written consent of the Company.

NOTES

H3G & EE 3No. KATHREIN 742234 ANTENNAS AT 15.0m MEAN, BEARINGS 20°, 90° & 290° E.T.N. I.D. No's. EQU900463139, EQU900463140 & EQU900463141

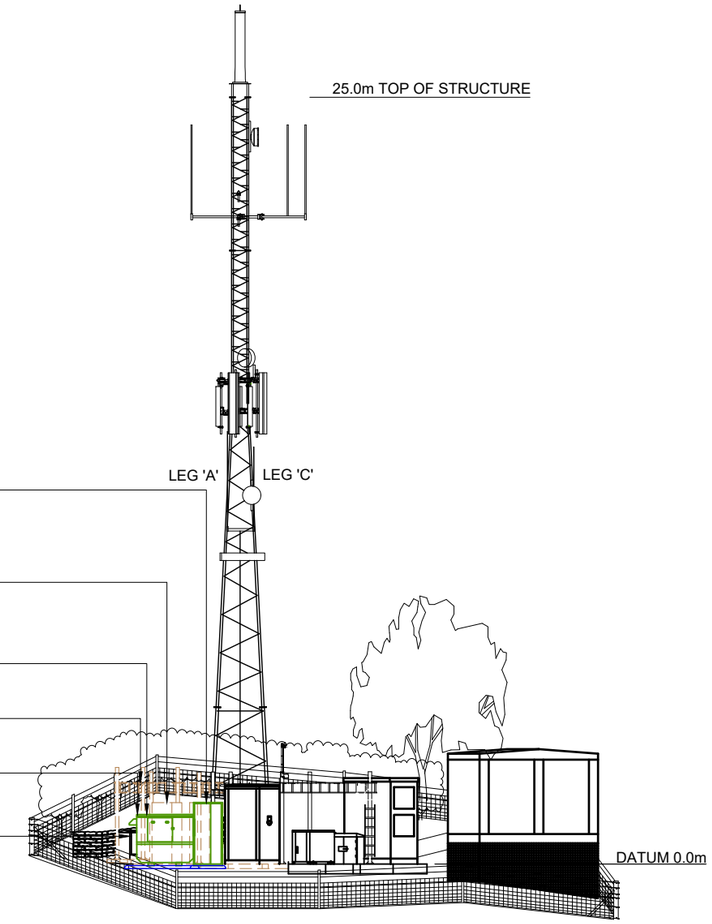

PROPOSED EE 1No. 21kW VERTIV PSU CABINET c/w 1No. STRING OF BATTERIES TO BE INSTALLED ON PROPOSED CONCRETE BASE

H3G & EE 3No. REDUNDANT CABINETS & CONCRETE FOUNDATION TO BE REMOVED

PROPOSED EE 1No. SINGLE SIDED 10kVA CANOPIED GENERATOR TO BE INSTALLED ON NEW CONCRETE FOUNDATION

H3G & EE 300mm WIDE CABLE TRAY c/w 5No. GANTRY POLE TO BE REMOVED

PROPOSED EE 1No. AMF PANEL TO BE INSTALLED ON NEW GANTRY POLE FIXED TO CONCRETE BASE (BEHIND)

H3G & EE 1No. METER CABINET

NORTH EAST ELEVATION

0 1m 5m 10m

FEINT DETAILS INDICATE LOCATIONS RESERVED FOR OTHER PROPOSALS WHICH MAY BE THE SUBJECT OF SEPARATE APPLICATIONS

SITERRA No.	12296585			
PROJ No.	COL.MOD.UK.0010005			
CELL No.	CLY0033			
21	PROJ No 12296585 PLANNING	04/03/26	WHP	WHP
20	PROJ No 211203 AS BUILT	20/01/20	HFC	MF
19	PROJ No 205833 AS-BUILT	07/01/19	WHP	MF
18	PROJ No 194618 AS BUILT	30/07/18	PS	JY
17	PROJ No 205606 AS BUILT	16/07/18	DAL	MF
ISS	REVISION	DATE	DRN	APP

arqiva

Crawley Court, Winchester, Hampshire, SO21 2QA
Tel. 01962 823434, Fax. 01962 822378

SITE No 14515
CEFN MAWR
PEN-Y-GRAIG,
FRONCYSYLLTE,
LLANGOLLEN
WREXHAM
LL20 7RT

NGR SJ 26782 40926

OS GRID 326782 340926

TITLE
ELEVATION
PROPOSED
H3G & EE LTD

SCALE 1:200

DRAWN	MF	15/09/09
APPROVED	WHP	04/03/26

DRG No. 14515-02-150-MD021 | Sheet 1 of 1 | Rev 21

A3